

MISSISSIPPI DEPARTMENT OF NATURAL RESOURCES

Bureau of Land and Water Resources

P.O. Box 10631

Jackson, Mississippi 39209

WATER WELL DRILLERS LOG

COUNTY WELL LOCATED Harrison
WELL NUMBER K 206
DATE WELL COMPLETED June 23-87

PERMIT NUMBER 0-239
NAME OF DRILLING FIRM MCGILL PUMP & WELLS
RT1 BOX 1643 CANAL RD GUPT, MS 39503

NAME & MAILING ADDRESS OF LANDOWNER Larry Melton 28th Street		
Shelfport ms.		
WELL LOCATION: SEC	TOWNSHIP	RANGE
33	7	12
DISTANCE	DIRECTION	NEAREST TOWN
4 Miles	West of	Gpt.
OTHER LANDMARK		
WELL PURPOSE <input checked="" type="checkbox"/> Home <input type="checkbox"/> Irrigation, Municipal, Industrial, Fish Pond, etc.		

PUMP DATA		
PUMP TYPE (Circle One): Submersible, Turbine, <input checked="" type="checkbox"/> Jet, Flowing Well, Other (Describe) _____		
POWER TYPE (Circle One): <input checked="" type="checkbox"/> Electric, Tractor, Diesel, Gasoline, Butane, Other (Describe) _____		
Pump Capacity (GPM) 13	No. of Stages 2	Setting Depth 60' FT.
PUMP TEST		
Well yielded 10 GPM with a drawdown of 10 ft. after 1 hours of pumping		

WELL DATA		
Well Depth 480'	Casing Diameter (In.) 2"	Casing Length (Ft.) 480'
Type of Casing PVC	Hole Depth 480'	Depth to Static Water Level 40'
TYPE OF COMPLETION: (Circle One or More): <input type="checkbox"/> Gravel Packed, <input type="checkbox"/> Underreamed, <input type="checkbox"/> Telescoped, <input checked="" type="checkbox"/> Natural Development, <input type="checkbox"/> Open Hole, <input type="checkbox"/> Other (Describe) _____		
Top of Lap Pipe or Reduction in Casing		
FEET	IF TELESCOPED OR MORE THAN ONE SCREEN: USE BACK PAGE	

LOG DATA	
TYPE OF LOG RUN (Circle One): <input checked="" type="checkbox"/> No-Log Run, <input type="checkbox"/> Gamma Ray, Density, Sonic, Neutron, Other (Describe) _____	
Name of Organization Running Log	

SCREEN DATA		
Diameter - Inches 2"	Length - Feet 10'	Slot Size - Inches 6ths.
Screen Type PVC	Depth to Bottom - Feet 480'	

GEOLOGIC DATA (Office Use Only)			
Surface Elev.	Geologic Unit	Unit Thickness	Depth to Top
Subs. SWL	Date	Analysis	Aquifer Test
Driller's Remarks			

DESCRIPTION OF FORMATIONS ENCOUNTERED	FROM	TO
mud	0	450
Sand	450	480'

RECEIVED


JUL 24 1987

Department of Natural Resources
Bureau of Land & Water Resources

IF MORE SPACE IS NEEDED, USE BACK

If well telescopes please sketch and show depths.

GROUND LEVEL

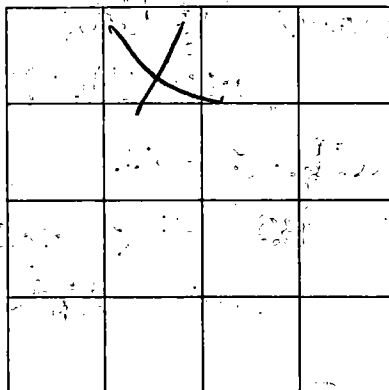

SECTION _____

Please indicate well location X.

ADDITIONAL INFORMATION

If more than one screen,
show location of each on sketch.