

**MISSISSIPPI DEPARTMENT OF NATURAL RESOURCES**  
Bureau of Land and Water Resources

P.O. Box 10631  
Jackson, Mississippi 39209  
**WATER WELL DRILLERS LOG**

COUNTY WELL LOCATED <b>Harrison</b>
WELL NUMBER <b>R 2076</b>
DATE WELL COMPLETED <b>9-11-87</b>

PERMIT NUMBER <b>0239</b>
NAME OF DRILLING FIRM <b>regilio pump &amp; well</b>
<b>1643 Canal Rd. Apt.</b>

NAME & MAILING ADDRESS OF LANDOWNER <b>Fred Westermeyer</b>
<b>London Lake Est.</b>
WELL LOCATION: SEC <b>11</b> TOWNSHIP <b>7</b> RANGE <b>12</b> <b>N</b> <b>E</b>
DISTANCE <b>5</b> Miles <b>West</b> of <b>Apt.</b>
OTHER LANDMARK
WELL PURPOSE: <input checked="" type="checkbox"/> Home Irrigation, <input type="checkbox"/> Municipal, <input type="checkbox"/> Industrial, <input type="checkbox"/> Fish Pond, etc.

<b>PUMP DATA</b>		
PUMP TYPE (Circle One): Submersible, Turbine, <input checked="" type="radio"/> Jet, Flowing Well, Other (Describe) _____		
POWER TYPE (Circle One): <input checked="" type="radio"/> Electric, Tractor, Diesel, Gasoline, Butane, Other (Describe) _____		
Pump Capacity (GPM) <b>12</b>	No. of Stages <b>2</b>	Setting Depth <b>80'</b> FT.
PUMP TEST		
Well yielded <del>12</del> <b>8</b> GPM with a drawdown of <b>10</b> ft. after <b>1</b> hours of pumping		

<b>WELL DATA</b>		
Well Depth <b>560</b>	Casing Diameter (In.) <b>2"</b>	Casing Length (Ft.) <b>550</b>
Type of Casing <b>PVC</b>	Hole Depth <b>560</b>	Depth to Static Water Level <b>460'</b>
TYPE OF COMPLETION: (Circle One or More): <input checked="" type="checkbox"/> Gravel Packed, <input type="checkbox"/> Underreamed, <input type="checkbox"/> Telescoped, <input checked="" type="checkbox"/> Natural Development, <input type="checkbox"/> Open Hole, <input type="checkbox"/> Other (Describe) _____		
Top of Lap Pipe or Reduction in Casing <b>FEET</b> IF TELESCOPED OR MORE THAN ONE SCREEN: USE BACK PAGE		

<b>LOG DATA</b>	
TYPE OF LOG RUN (Circle One): Electric, Gamma Ray, Density, Sonic, Neutron, Other (Describe) _____	
<input checked="" type="radio"/> No Log Run	
Name of Organization Running Log	

<b>SCREEN DATA</b>		
Diameter - Inches <b>2"</b>	Length - Feet <b>10'</b>	Slot Size - Inches <b>.0006</b>
Screen Type <b>PVC</b>	Depth to Bottom - Feet <b>560</b>	

<b>GEOLOGIC DATA (Office Use Only)</b>			
Surface Elev.	Geologic Unit	Unit Thickness	Depth to Top
Subs. SWL	Date	Analysis	Aquifer Test
Driller's Remarks			

DESCRIPTION OF FORMATIONS ENCOUNTERED	FROM	TO	FORMATION ENCOUNTERED	FROM	TO
<b>mud</b>	<b>0</b>	<b>10</b>			
<b>Sand</b>	<b>10</b>	<b>40</b>			
<b>Mud</b>	<b>40</b>	<b>180</b>			
<b>Sand</b>	<b>180</b>	<b>220</b>			
<b>Mud</b>	<b>220</b>	<b>420</b>			
<b>Sand</b>	<b>420</b>	<b>430</b>			
<b>Mud</b>	<b>430</b>	<b>520</b>			
<b>Sand</b>	<b>520</b>	<b>560</b>			


**RECEIVED**  
**OCT 14 1987**

Department of Natural Resources  
Bureau of Land & Water Resources

IF MORE SPACE IS NEEDED, USE BACK

If well telescopes please sketch and show depths.

GROUND LEVEL

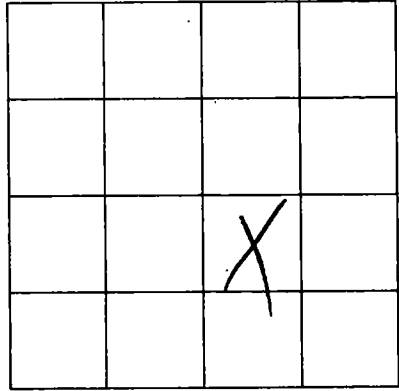

SECTION \_\_\_\_\_

Please indicate well location X.

ADDITIONAL INFORMATION

If more than one screen,  
show location of each on sketch.