

MISSISSIPPI DEPARTMENT OF NATURAL RESOURCES

Bureau of Land and Water Resources

Southport Mall

P.O. Box 10631

Jackson, Mississippi 39209

WATER WELL DRILLERS LOG

Harrison
K 279
10-2-87 19

R. J. Moore
firm name

HARRISON
county well located

LANDOWNER: James Raffeo
Bas Arque RD +
58 ST Cochran MS

description of formations encountered

from

to

Top Soil + Clay

0 20

White Sand + Gravel

20 46

Blue Clay

40 500

Coarse Sand

500 518

(mailing address)

WELL LOCATION:

sec. 35 T 7 N R 12 E
2 miles N of Berch
(distance) (direction) (nearest town)

WELL PURPOSE:

(home) Irrigation, municipal, industrial

WELL COMPLETION DATA:

- (1) diameter (Inches) 2"
- (2) total depth (feet) 518'
- (3) static water level (feet) 26' ^{below} _{above} top of ground.
- (4) casing Pvc, 518',
(material) (depth)
(size) if telescope see back.
- (5) screen 11', 518'
(length) (depth to top)
2", Pvc
(size) (material)
- (6) pump 1, 6
(HP) (yield gpm)
E
(type power)
- (7) electric log
(yes or no)

(organization running log)

(8) how well bottom plugged

DRILLERS REMARKS:


RECEIVED

NOV 04 1987

Department of Natural Resources
Bureau of Land & Water Resources

If well telescopes please sketch and show depths.

GROUND LEVEL

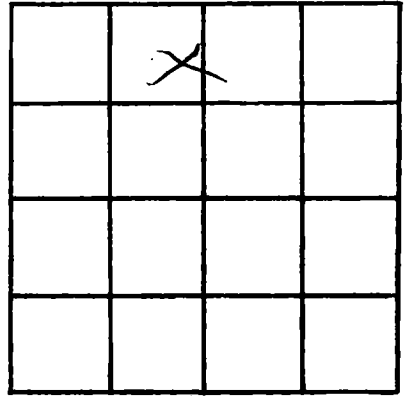

SECTION 3.5

Please indicate well location X.

ADDITIONAL INFORMATION

If more than one screen, show locations of each on sketch.