

MISSISSIPPI DEPARTMENT OF NATURAL RESOURCES
Bureau of Land and Water Resources

P.O. Box 10631

Jackson, Mississippi 39209

WATER WELL DRILLERS LOG

COUNTY WELL LOCATED <i>Jackson</i>
WELL NUMBER <i>R 2222</i>
DATE WELL COMPLETED <i>Aug. 22-87</i>

PERMIT NUMBER <i>0239</i>
NAME OF DRILLING FIRM <i>McGhee Pump & Well</i>
<i>1643 Canal rd. East.</i>

NAME & MAILING ADDRESS OF LANDOWNER <i>Spencer Gray</i> <i>11340 Allen rd.</i> <i>East. Ms.</i>		
WELL LOCATION: SEC <i>11</i>	TOWNSHIP <i>7</i>	RANGE <i>12</i>
DISTANCE <i>4</i> Miles	DIRECTION <i>West</i> of	NEAREST TOWN <i>East.</i>
OTHER LANDMARK		
WELL PURPOSE: <input checked="" type="checkbox"/> Home Irrigation, <input type="checkbox"/> Municipal, <input type="checkbox"/> Industrial, <input type="checkbox"/> Fish Pond, etc.		

PUMP DATA		
PUMP TYPE (Circle One): Submersible, Turbine, <input checked="" type="radio"/> Jet, Flowing Well, Other (Describe)		
POWER TYPE (Circle One): <input checked="" type="radio"/> Electric, Tractor, Diesel, Gasoline, Butane, Other (Describe)		
Pump Capacity (GPM) <i>12</i>	No. of Stages <i>2</i>	Setting Depth <i>60'</i> FT.
PUMP TEST		
Well yielded <i>10</i> GPM with a drawdown of <i>8</i> ft. after <i>1</i> hours of pumping		

WELL DATA

Well Depth <i>220</i>	Casing Diameter (In.) <i>2"</i>	Casing Length (Ft.) <i>220</i>
Type of Casing <i>PVC</i>	Hole Depth <i>220</i>	Depth to Static Water Level <i>40'</i>
TYPE OF COMPLETION: (Circle One or More): <input checked="" type="checkbox"/> Gravel Packed, <input type="checkbox"/> Underreamed, <input type="checkbox"/> Telescoped, <input checked="" type="checkbox"/> Natural Development, <input type="checkbox"/> Open Hole, <input type="checkbox"/> Other		
Top of Lap Pipe or Reduction in Casing		
FEET	IF TELESCOPED OR MORE THAN ONE SCREEN: USE BACK PAGE	

LOG DATA

TYPE OF LOG RUN (Circle One): Electric, Gamma Ray, Density, Sonic, Neutron, Other (Describe) <input checked="" type="checkbox"/> No Log Run,
Name of Organization Running Log

GEOLOGIC DATA (Office Use Only)

Surface Elev.	Geologic Unit	Unit Thickness	Depth to Top
Subs. SWL	Date	Analysis	Aquifer Test

Driller's Remarks

SCREEN DATA

Diameter - Inches <i>2"</i>	Length - Feet <i>10'</i>	Slot Size - Inches <i>.0006</i>
Screen Type <i>PVC</i>	Depth to Bottom - Feet <i>220'</i>	


RECEIVED

DESCRIPTION OF FORMATIONS ENCOUNTERED	FROM	TO	FORMATIONS (continued)	FROM	TO
<i>mud</i>	<i>0</i>	<i>10</i>	<i>OCT 14 1987</i>		
<i>Sand</i>	<i>10</i>	<i>40</i>			
<i>mud</i>	<i>40</i>	<i>196</i>			
<i>Sand</i>	<i>190</i>	<i>220</i>			

IF MORE SPACE IS NEEDED, USE BACK

If well telescopes please
sketch and show depths.

GROUND LEVEL

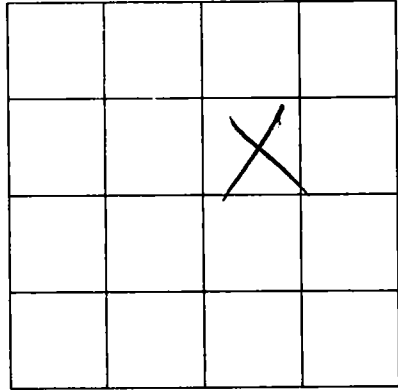

SECTION _____

Please indicate well location X.

ADDITIONAL INFORMATION

A series of horizontal lines for writing additional information.

If more than one screen,
show location of each on sketch.