

MISSISSIPPI DEPARTMENT OF NATURAL RESOURCES

Bureau of Land and Water Resources

Southport Mall

P.O. Box 10631

Jackson, Mississippi 39209

WATER WELL DRILLERS LOG

| |
|-----------------|
| HARRISON |
| 0239 |
| K |
| 2090 |

October 9 19 88 McMill Pumpwell Harrison
 date well completed firm name county well located

LANDOWNER: Randy Hertz
202 White Harbor rd
Long Beach Ms.
(mailing address)

WELL LOCATION:
 sec. 27 T. 2 N. R. 12 E.
2 miles South of I-10 Long
(distance) (direction) (nearest town)

WELL PURPOSE:
 (home) irrigation, municipal, industrial

- WELL COMPLETION DATA:**
- (1) diameter (inches) 2"
 - (2) total depth (feet) 320'
 - (3) static water level (feet) 20' below above top of ground
 - (4) casing PVC, 510'
(material) (depth)
2" If telescope see back.
(size)
 - (5) screen 10', 320
(length) (depth to top)
2" PVC
(size) (material)
 - (6) pump 1 13
(HP) (yield gpm)
electric
(type power)
 - (7) electric log (yes or no)
- (organization running log)
- (8) how well bottom plugged seal

| description of formations encountered | from | to |
|---------------------------------------|------|-----|
| Mud | 0 | 10 |
| Sand | 10 | 40 |
| Sand / Shovel | 40 | 50 |
| Mud | 50 | 180 |
| Sand | 180 | 230 |
| Mud | 230 | 480 |
| Sand | 480 | 520 |

RECEIVED


JAN 27 1988

Department of Natural Resources
Bureau of Land & Water Resources

DRILLERS REMARKS:

If well telescopes please sketch and show depths.

GROUND LEVEL

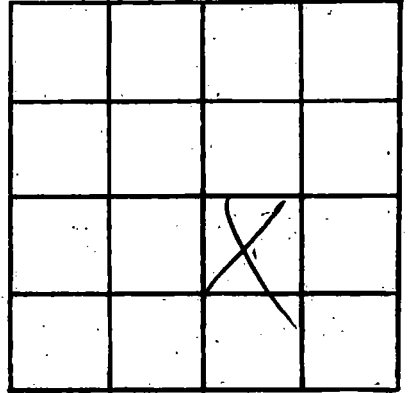

SECTION _____

Please indicate well location X.

ADDITIONAL INFORMATION

RECEIVED

RECEIVED

If more than one screen, show locations of each on sketch.