

MISSISSIPPI DEPARTMENT OF NATURAL RESOURCES

Bureau of Land and Water Resources

P.O. Box 10631

Jackson, Mississippi 39209

WATER WELL DRILLERS LOG

COUNTY WELL LOCATED <i>Harrison</i>	
WELL NUMBER <i>K</i>	CODED
<i>2092</i>	
DATE WELL COMPLETED <i>6/30/67</i>	

PERMIT NUMBER
NAME OF DRILLING FIRM <i>Lyman Well Co</i>

NAME & MAILING ADDRESS OF LANDOWNER <i>Halley's Auto Salvage</i>		
<i>Canal Rd.</i>		
<i>Gulfport MS 39503</i>		
WELL LOCATION: SEC	TOWNSHIP	RANGE
<i>25</i>	<i>7</i>	<i>12 E</i>
DISTANCE	DIRECTION	NEAREST TOWN
<i>2</i> Miles	<i>North</i>	<i>Gulfport</i>
OTHER LANDMARK <i>Area of Naval Reservation</i>		
WELL PURPOSE: <input checked="" type="checkbox"/> Home, <input type="checkbox"/> Irrigation, <input type="checkbox"/> Municipal, <input type="checkbox"/> Industrial, <input type="checkbox"/> Fish Pond, etc.		

PUMP DATA		
PUMP TYPE (Circle One): <input checked="" type="checkbox"/> Submersible, <input type="checkbox"/> Turbine, <input type="checkbox"/> Jet, <input type="checkbox"/> Flowing Well, Other (Describe) _____		
POWER TYPE (Circle One): <input checked="" type="checkbox"/> Electric, <input type="checkbox"/> Tractor, <input type="checkbox"/> Diesel, <input type="checkbox"/> Gasoline, <input type="checkbox"/> Butane, Other (Describe) _____		
Pump Capacity (GPM) <i>25</i>	No. of Stages <i>7</i>	Setting Depth <i>60'</i> FT.
PUMP TEST		
Well yielded _____ GPM with a drawdown of _____ ft. after _____ hours of pumping		


WELL DATA		
Well Depth <i>435</i>	Casing Diameter (In.) <i>4x2</i>	Casing Length (Ft.) <i>415'</i>
Type of Casing <i>PVC</i>	Hole Depth <i>435</i>	Depth to Static Water Level <i>22'</i>
TYPE OF COMPLETION: (Circle One or More): <input checked="" type="checkbox"/> Gravel Packed, <input type="checkbox"/> Underreamed, <input type="checkbox"/> Telescoped, <input checked="" type="checkbox"/> Natural Development, <input type="checkbox"/> Open Hole, <input type="checkbox"/> Other		
Top of Lap Pipe or Reduction in Casing		
FEET	IF TELESCOPED OR MORE THAN ONE SCREEN: USE BACK PAGE	

LOG DATA	
TYPE OF LOG RUN (Circle One): <input checked="" type="checkbox"/> No Log Run, <input type="checkbox"/> Electric, <input type="checkbox"/> Gamma Ray, <input type="checkbox"/> Density, <input type="checkbox"/> Sonic, <input type="checkbox"/> Neutron, Other (Describe) _____	
Name of Organization Running Log	

SCREEN DATA		
Diameter - Inches <i>2"</i>	Length - Feet <i>20</i>	Slot Size - Inches <i>.008</i>
Screen Type <i>PVC Samed. Slotted</i>	Depth to Bottom - Feet <i>435</i>	

GEOLOGIC DATA (Office Use Only)			
Surface Elev.	Geologic Unit	Unit Thickness	Depth to Top
Subs. SWL	Date	Analysis	Aquifer Test
Driller's Remarks <i>None</i>			

DESCRIPTION OF FORMATIONS ENCOUNTERED	FROM	TO
<i>Topsoil - Sand - Clay</i>	<i>0-</i>	<i>156'</i>
<i>clay</i>	<i>156'</i>	<i>186'</i>
<i>Sand & clay</i>	<i>186'</i>	<i>410'</i>
<i>Sand</i>	<i>410'</i>	<i>435'</i>



RECEIVED

FEB 22 1968


Department of Natural Resources
Bureau of Land & Water Resources

FORMATIONS (Continued)	FROM	TO

IF MORE SPACE IS NEEDED, USE BACK

If well telescopes please sketch and show depths.

GROUND LEVEL

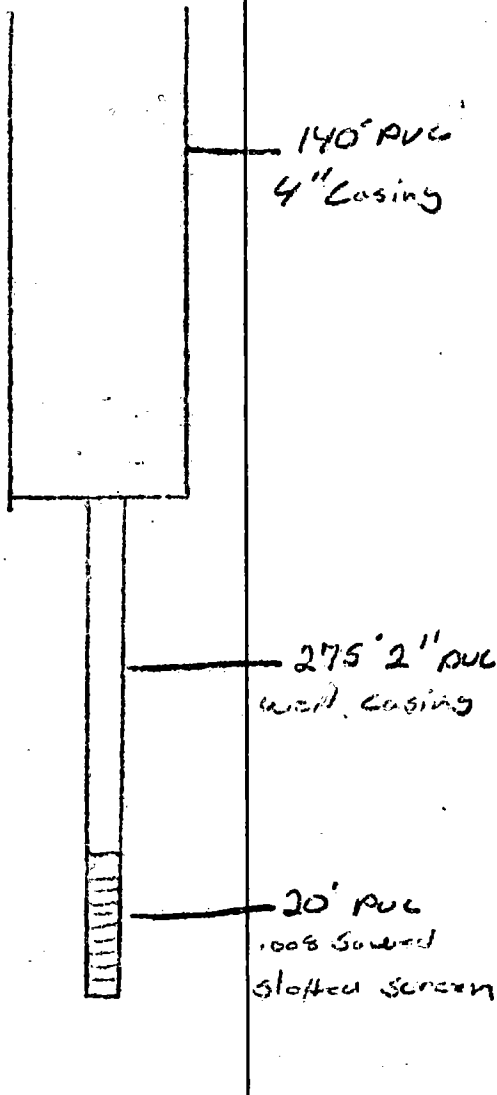

	X		

SECTION 25

Please indicate well location X.

ADDITIONAL INFORMATION

If more than one screen, show location of each on sketch.