

MISSISSIPPI DEPARTMENT OF NATURAL RESOURCES
Bureau of Land and Water Resources

P.O. Box 10631
Jackson, Mississippi 39209
WATER WELL DRILLERS LOG

COUNTY WELL LOCATED <i>Harrison</i>	
WELL NUMBER <i>K</i>	CODED
<i>2094</i>	
DATE WELL COMPLETED <i>9-28-87</i>	

PERMIT NUMBER
NAME OF DRILLING FIRM <i>Max B Drilling Co.</i>

NAME & MAILING ADDRESS OF LANDOWNER <i>Charles Currie</i>			
<i>23323 Placide Rd</i>			
<i>Pass Christian, Miss. 39571</i>			
WELL LOCATION:	SEC	TOWNSHIP	RANGE
	<i>18</i>	<i>7</i>	<i>S 12 W</i>
DISTANCE	DIRECTION	NEAREST TOWN	
<i>4</i>	<i>NE</i>	<i>Andale</i>	
OTHER LANDMARK			
WELL PURPOSE: Home, Irrigation, Municipal, Industrial, Fish Pond, etc. <i>Home</i>			

PUMP DATA		
PUMP TYPE (Circle One): <input checked="" type="radio"/> Submersible Turbine Jet Flowing Well, Other (Describe) _____		
POWER TYPE (Circle One): <input checked="" type="radio"/> Electric Tractor Diesel Gasoline Butane, Other (Describe) _____		
Pump Capacity (GPM) <i>25</i>	No. of Stages	Setting Depth <i>100</i> FT.
PUMP TEST		
Well yielded _____ GPM with a drawdown of _____ ft. after _____ hours of pumping		

WELL DATA		
Well Depth <i>360</i>	Casing Diameter (In.) <i>4" x 2"</i>	Casing Length (Ft.) <i>350</i>
Type of Casing <i>PVC</i>	Hole Depth <i>360</i>	Depth to Static Water Level <i>30</i>
TYPE OF COMPLETION: (Circle One or More): <input checked="" type="checkbox"/> Gravel Packed <input type="checkbox"/> Underreamed <input type="checkbox"/> Telescoped, <input checked="" type="checkbox"/> Natural Development <input type="checkbox"/> Open Hole <input type="checkbox"/> Other (Describe) _____		
Top of Lap Pipe or Reduction in Casing		
FEET	IF TELESKOPED OR MORE THAN ONE SCREEN: USE BACK PAGE	

LOG DATA	
TYPE OF LOG RUN (Circle One): Electric, Gamma Ray, Density, Sonic, Neutron, Other (Describe) _____ <input checked="" type="radio"/> No Log Run	
Name of Organization Running Log	

SCREEN DATA		
Diameter - Inches <i>2</i>	Length - Feet <i>10</i>	Slot Size - Inches <i>.008</i>
Screen Type <i>PVC WOP</i>	Depth to Bottom - Feet <i>360</i>	



GEOLOGIC DATA (Office Use Only)			
Surface Elev.	Geologic Unit	Unit Thickness	Depth to Top
Subs. SWL	Date	Analysis	Aquifer Test
Driller's Remarks			

RECEIVED
ALL

DESCRIPTION OF FORMATIONS ENCOUNTERED	FROM	TO	FORMATIONS (Continued)	
			FROM	TO
<i>Surface</i>	<i>0</i>	<i>6</i>	<i>FEB 22 1988</i>	
<i>Sand or gravel</i>	<i>6</i>	<i>90</i>		
<i>Blue clay</i>	<i>90</i>	<i>140</i>		
<i>Sand & clay layers</i>	<i>140</i>	<i>190</i>		
<i>Blue clay</i>	<i>190</i>	<i>310</i>		
<i>Coarse grey sand</i>	<i>310</i>	<i>360</i>	<i>+</i>	

IF MORE SPACE IS NEEDED, USE BACK

If well telescopes please sketch and show depths.

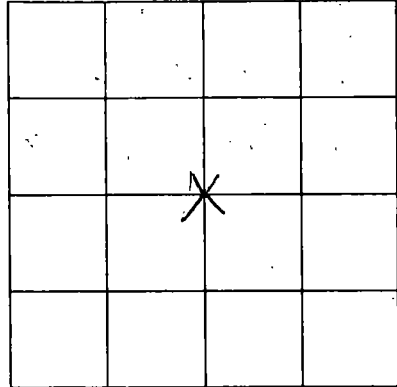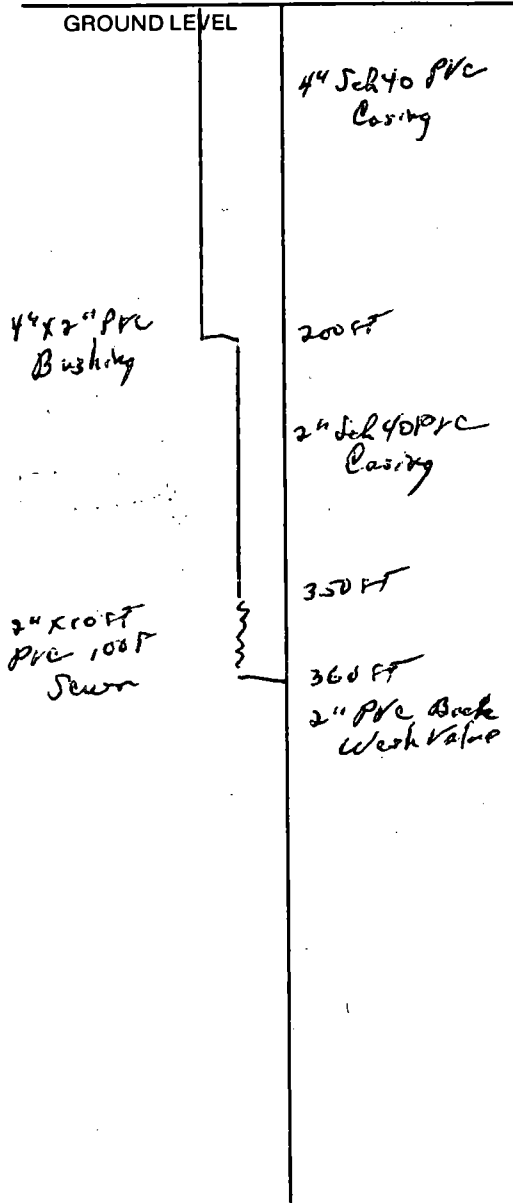

SECTION 18

Please indicate well location X.

ADDITIONAL INFORMATION

Lined area for additional information.

If more than one screen, show location of each on sketch.