

MISSISSIPPI DEPARTMENT OF NATURAL RESOURCES
Bureau of Land and Water Resources

P.O. Box 10631
Jackson, Mississippi 39209
WATER WELL DRILLERS LOG

COUNTY WELL LOCATED <i>Harrison</i>	
WELL NUMBER <i>K</i>	CODED
<i>2076</i>	
DATE WELL COMPLETED <i>11-29-87</i>	

PERMIT NUMBER
NAME OF DRILLING FIRM <i>Max B. Sr. Hing Co.</i>

NAME & MAILING ADDRESS OF LANDOWNER <i>John Stinson</i>		
<i>8206 County Farm Rd</i>		
<i>Sulphur, Miss. 39503</i>		
WELL LOCATION: SEC	TOWNSHIP	RANGE
<i>28</i>	<i>7</i>	<i>12</i>
	<i>S</i>	<i>W</i>
DISTANCE	DIRECTION	NEAREST TOWN
<i>5</i> Miles	<i>N</i>	<i>Pass Christian</i>
OTHER LANDMARK		
WELL PURPOSE: Home, Irrigation, Municipal, Industrial, Fish Pond, etc. <i>Home</i>		

PUMP DATA		
PUMP TYPE (Circle One): Submersible, Turbine, <u>Jet</u> Flowing Well, Other (Describe) _____		
POWER TYPE (Circle One): <u>Electric</u> , Tractor, Diesel, Gasoline, Butane, Other (Describe) _____		
Pump Capacity (GPM) <i>8</i>	No. of Stages <i>1</i>	Setting Depth <i>50</i> FT.
PUMP TEST		
Well yielded <i>15</i> GPM with a drawdown of _____ ft. after _____ hours of pumping		

WELL DATA		
Well Depth <i>600</i>	Casing Diameter (In.) <i>2"</i>	Casing Length (Ft.) <i>590</i>
Type of Casing <i>PVC</i>	Hole Depth <i>600</i>	Depth to Static Water Level <i>27</i>
TYPE OF COMPLETION: (Circle One or More): Gravel Packed, Underreamed, Telescoped, <u>Natural Development</u> , Open Hole, Other		
Top of Lap Pipe or Reduction in Casing		
FEET	IF TELESKOPED OR MORE THAN ONE SCREEN: USE BACK PAGE	

LOG DATA	
TYPE OF LOG RUN (Circle One): Electric, Gamma Ray, Density, Sonic, <u>No Log Run</u> , Neutron, Other (Describe) _____	
Name of Organization Running Log	

SCREEN DATA		
Diameter - Inches <i>2</i>	Length - Feet <i>10</i>	Slot Size - Inches <i>.008</i>
Screen Type <i>PVC wrapped</i>	Depth to Bottom - Feet <i>600</i>	

GEOLOGIC DATA (Office Use Only)			
Surface Elev.	Geologic Unit	Unit Thickness	Depth to Top
Subs. SWL	Date	Analysis	Aquifer Test

Driller's Remarks


RECEIVED

DESCRIPTION OF FORMATIONS ENCOUNTERED	FROM	TO	DESCRIPTIONS (Continued)	FROM	TO
<i>Surface</i>	<i>0</i>	<i>10</i>	FEB 22 1988 Department of Natural Resources Bureau of Land & Water Resources		
<i>Sands Clay Layers</i>	<i>10</i>	<i>60</i>			
<i>Blue Clay</i>	<i>60</i>	<i>192</i>			
<i>Powder Sand (Fine)</i>	<i>192</i>	<i>200</i>			
<i>Blue Clay</i>	<i>200</i>	<i>520</i>			
<i>Medium Clay Sand</i>	<i>520</i>	<i>598</i>			
<i>Blue Clay</i>	<i>598</i>	<i>600</i>			

IF MORE SPACE IS NEEDED, USE BACK

If well telescopes please sketch and show depths.

GROUND LEVEL

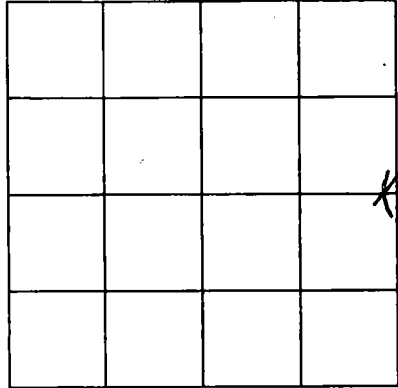

SECTION 2P

Please indicate well location X.

ADDITIONAL INFORMATION

If more than one screen, show location of each on sketch.