

**MISSISSIPPI DEPARTMENT OF NATURAL RESOURCES**  
Bureau of Land and Water Resources

P.O. Box 10631  
Jackson, Mississippi 39209  
**WATER WELL DRILLERS LOG**

COUNTY WELL LOCATED <i>Harrison</i>	
WELL NUMBER <i>K</i>	CODED
<i>2097</i>	
DATE WELL COMPLETED <i>1/20/87</i>	

PERMIT NUMBER
NAME OF DRILLING FIRM <i>Lyman</i>

NAME & MAILING ADDRESS OF LANDOWNER <i>David Ray</i>		
<i>P.O. Box 394</i>		
<i>Long Beach 39660</i>		
WELL LOCATION: SEC	TOWNSHIP	RANGE
<i>27</i>	<i>7 N</i>	<i>12 E</i>
DISTANCE	DIRECTION	NEAREST TOWN
<i>3</i> Miles	<i>North</i>	<i>Long Beach</i>
OTHER LANDMARK <i>4 mile South I-10</i>		
WELL PURPOSE <input checked="" type="radio"/> Home Irrigation, Municipal, Industrial, Fish Pond, etc.		

<b>PUMP DATA</b>		
PUMP TYPE (Circle One): <input checked="" type="radio"/> Submersible Turbine Jet Flowing Well. Other (Describe) _____		
POWER TYPE (Circle One): Electric Tractor Diesel Gasoline Butane. Other (Describe) _____		
Pump Capacity (GPM) <i>25</i>	No. of Stages <i>7</i>	Setting Depth <i>60'</i> FT.
PUMP TEST		
Well yielded _____ GPM with a drawdown of _____ ft. after _____ hours of pumping		

<b>WELL DATA</b>		
Well Depth <i>615'</i>	Casing Diameter (In.) <i>4x2</i>	Casing Length (Ft.) <i>595'</i>
Type of Casing <i>PVC</i>	Hole Depth <i>615</i>	Depth to Static Water Level <i>30'</i>
TYPE OF COMPLETION: (Circle One or More): Gravel Packed, Underreamed, Telescoped, <input checked="" type="radio"/> Natural Development, Open Hole, Other (Describe) _____		
Top of Lap Pipe or Reduction in Casing FEET IF TELESCOPED OR MORE THAN ONE SCREEN: USE BACK PAGE		

<b>LOG DATA</b>	
TYPE OF LOG RUN (Circle One): Electric, Gamma Ray, Density, Sonic, Neutron, Other (Describe) _____ <input checked="" type="radio"/> No Log Run	
Name of Organization Running Log	


<b>SCREEN DATA</b>		
Diameter - Inches <i>2"</i>	Length - Feet <i>20</i>	Slot Size - Inches <i>.006</i>
Screen Type <i>Pvc Samed Slotted</i>	Depth to Bottom - Feet <i>615</i>	

<b>GEOLOGIC DATA (Office Use Only)</b>			
Surface Elev.	Geologic Unit	Unit Thickness	Depth to Top
Subs. SWL	Date	Analysis	Aquifer Test
Driller's Remarks <i>None</i>			

DESCRIPTION OF FORMATIONS ENCOUNTERED	FROM	TO
<i>Topsoil &amp; sandy clay</i>	<i>0</i>	<i>2'</i>
<i>Granite</i>	<i>2'</i>	<i>26'</i>
<i>Clay &amp; sand</i>	<i>26'</i>	<i>580'</i>
<i>Sand</i>	<i>580'</i>	<i>615'</i>

<b>RECEIVED</b>	
FEB 22 1987	
Department of Natural Resources Bureau of Land & Water Resources	
IF MORE SPACE IS NEEDED, USE BACK	

If well telescopes please sketch and show depths.

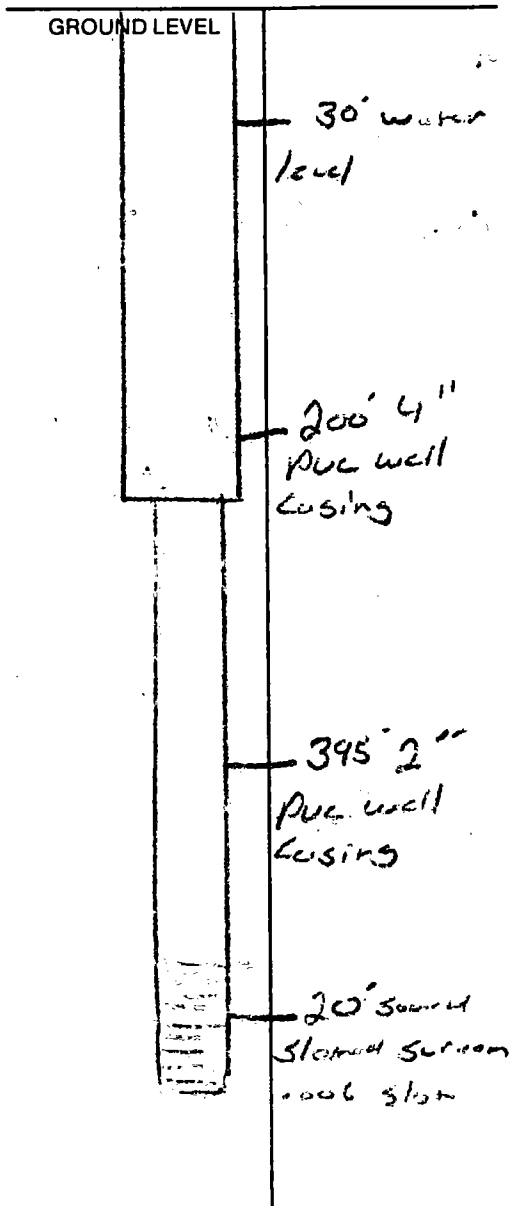

		X	

SECTION 27

Please indicate well location X.

ADDITIONAL INFORMATION

---

---

If more than one screen, show location of each on sketch.