

MISSISSIPPI DEPARTMENT OF NATURAL RESOURCES
Bureau of Land and Water Resources

P.O. Box 10631

Jackson, Mississippi 39209

WATER WELL DRILLERS LOG

COUNTY, WELL LOCATED HARRISON	
WELL NUMBER R 2104	CODED
DATE WELL COMPLETED MAY 3, 1988	

PERMIT NUMBER 0239
NAME OF DRILLING FIRM McCall Pump & Wells

NAME & MAILING ADDRESS OF LANDOWNER
Dorothy Whitman

Bazaar Rd.

WELL LOCATION: SEC **35** TOWNSHIP **7 N** RANGE **12 E**

DISTANCE **5** Miles DIRECTION **WEST** of NEAREST TOWN **Spt.**

OTHER LANDMARK
off 28th STREET

WELL PURPOSE: Home, Irrigation, Municipal, Industrial, Fish Pond, etc.
Home

PUMP DATA

PUMP TYPE (Circle One):
Submersible, Turbine, **Jet** Flowing Well, Other (Describe) _____

POWER TYPE (Circle One):
Electric Tractor, Diesel, Gasoline, Butane, Other (Describe) _____

Pump Capacity (GPM)	No. of Stages	Setting Depth
10	2	60' FT.

PUMP TEST
Well yielded **10** GPM with a drawdown of **10** ft. after **1** hours of pumping

WELL DATA

Well Depth	Casing Diameter (In.)	Casing Length (Fl.)
250'	3" 2"	250'

Type of Casing	Hole Depth	Depth to Static Water Level
PVC	250	40'

TYPE OF COMPLETION: (Circle One or More):
Gravel Packed, Underreamed, Telescoped, Natural Development, Open Hole, Other

Top of Lap Pipe or Reduction in Casing
FEET IF TELESCOPED OR MORE THAN ONE SCREEN: USE BACK PAGE

SCREEN DATA

Diameter - Inches	Length - Feet	Slot Size - Inches
2"	10'	.0006

Screen Type	Depth to Bottom - Feet
PVC	250'

LOG DATA

TYPE OF LOG RUN (Circle One):
Electric, Gamma Ray, Density, Sonic, **No Log Run**, Neutron, Other (Describe) _____

Name of Organization Running Log

GEOLOGIC DATA (Office Use Only)

Surface Elev.	Geologic Unit	Unit Thickness	Depth to Top
Subs. SWL	Date	Analysis	Aquifer Test

Driller's Remarks


RECEIVED

DESCRIPTION OF FORMATIONS ENCOUNTERED	FROM	TO	FORMATIONS (Symbol)	DATE
mud	0	10		JUN 17 1988
Sand	10	30		
mud	30	210		
Sand	210	250		

Department of Natural Resources
Bureau of Land & Water Resources

If well telescopes please sketch and show depths.

GROUND LEVEL

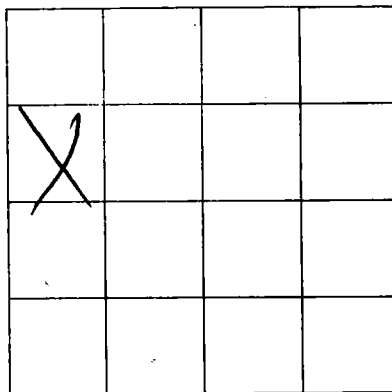

SECTION _____

Please indicate well location X.

ADDITIONAL INFORMATION

Lined area for providing additional information.

If more than one screen, show location of each on sketch.