




If well telescopes please sketch and show depths.

GROUND LEVEL

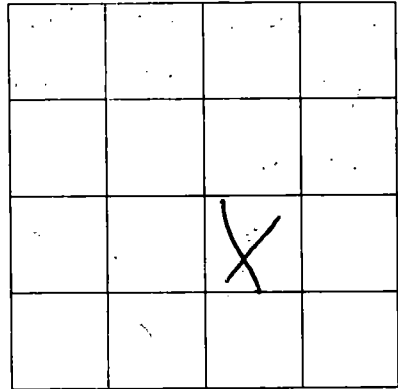

SECTION \_\_\_\_\_

Please indicate well location X.

ADDITIONAL INFORMATION

RECEIVED

NOV 10 1988

U.S. GEOLOGICAL SURVEY  
WATER RESOURCES DIVISION

If more than one screen,  
show location of each on sketch.