

**MISSISSIPPI DEPARTMENT OF NATURAL RESOURCES**  
Bureau of Land and Water Resources

P.O. Box 10631  
Jackson, Mississippi 39209  
**WATER WELL DRILLERS LOG**

COUNTY WELL LOCATED <b>Jackson</b>
WELL NUMBER <b>R 2111</b>
CODED
DATE WELL COMPLETED <b>4-12-89</b>

PERMIT NUMBER
NAME OF DRILLING FIRM/ <b>WALKER'S WELL</b>
<b>SERVICE</b>

NAME & MAILING ADDRESS OF LANDOWNER <b>GULF COAST SAND &amp; GRAVELL</b>		
Box 909 PICA YUME MISS 39466		
WELL LOCATION:	SEC	TOWNSHIP RANGE
	<b>28</b>	<b>7</b> <sup>N</sup> <sub>S</sub> <b>12</b> <sup>E</sup> <sub>W</sub>
DISTANCE	DIRECTION	NEAREST TOWN
<b>0.10</b> Miles	<b>10</b>	<b>of GULFPORT</b>
OTHER LANDMARK		
WELL PURPOSE: <input checked="" type="radio"/> Home Irrigation, Municipal, Industrial, Fish Pond, etc.		

<b>PUMP DATA</b>		
PUMP TYPE (Circle One): Submersible, Turbine, <input checked="" type="radio"/> Flowing Well, Other (Describe) _____		
POWER TYPE (Circle One): <input checked="" type="radio"/> Electric, Tractor, Diesel, Gasoline, Butane, Other (Describe) _____		
Pump Capacity (GPM)	No. of Stages	Setting Depth  <b>FT.</b>
PUMP TEST		
Well yielded _____ GPM with a drawdown of _____ ft. after _____ hours of pumping		

<b>WELL DATA</b>		
Well Depth <b>360</b>	Casing Diameter (In.) <b>2"</b>	Casing Length (Ft.) <b>350</b>
Type of Casing <b>PVC</b>	Hole Depth <b>360</b>	Depth to Static Water Level <b>10'</b>
TYPE OF COMPLETION: (Circle One or More): Gravel Packed, Underreamed, Telescoped, Natural Development, Open Hole, Other (Describe) _____		
Top of Lap Pipe or Reduction in Casing		
FEET	IF TELESCOPED OR MORE THAN ONE SCREEN: USE BACK PAGE	

<b>LOG DATA</b>	
TYPE OF LOG RUN (Circle One): Electric, Gamma Ray, Density, Sonic, Neutron, Other (Describe) _____	
Name of Organization Running Log	

<b>SCREEN DATA</b>		
Diameter - Inches <b>2"</b>	Length - Feet <b>10</b>	Slot Size - Inches <b>1/2</b>
Screen Type <b>SLOT</b>	Depth to Bottom - Feet <b>360</b>	


<b>GEOLOGIC DATA (Office Use Only)</b>			
Surface Elev.	Geologic Unit	Unit Thickness	Depth to Top
Subs. SWL	Date	Analysis	Aquifer Test
Driller's Remarks			

DESCRIPTION OF FORMATIONS ENCOUNTERED	FROM	TO					TO
<b>BLACK D.R.T</b>	<b>0</b>	<b>15</b>					
<b>SAND</b>	<b>15</b>	<b>25</b>					
<b>ROCKS + SAND</b>	<b>25</b>	<b>40</b>					
<b>ROCKS</b>	<b>40</b>	<b>50</b>					
<b>BLUE CLAY</b>	<b>50</b>	<b>300</b>					
<b>SAND</b>	<b>300</b>	<b>360</b>					
IF MORE SPACE IS NEEDED, USE BACK							

**RECEIVED**  
**MAY 11 1989**  
Department of Natural Resources  
Bureau of Land & Water Resources

If well telescopes please sketch and show depths.

GROUND LEVEL

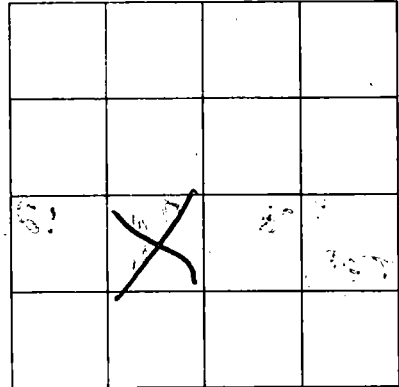

SECTION \_\_\_\_\_

Please indicate well location X.

ADDITIONAL INFORMATION

Multiple horizontal lines for additional information.

Faint, illegible text or a stamp at the bottom of the left column.

If more than one screen, show location of each on sketch.