

**MISSISSIPPI DEPARTMENT OF NATURAL RESOURCES**

Bureau of Land and Water Resources

P.O. Box 10631

Jackson, Mississippi 39209

**WATER WELL DRILLERS LOG**

COUNTY WELL LOCATED <i>Harrison</i>	
WELL NUMBER <i>K-2116</i>	CODED
DATE WELL COMPLETED <i>Nov. 9-88</i>	

PERMIT NUMBER <i>0239</i>
NAME OF DRILLING FIRM <i>McMill Pump &amp; Well</i>

NAME & MAILING ADDRESS OF LANDOWNER <i>Steve Harvey</i>			
<i>Lot 173 Maple Dagnolia</i>			
<i>Long Beach MS</i>			
WELL LOCATION: SEC	TOWNSHIP	RANGE	
<i>10</i>	<i>7</i>	<i>12</i>	
DISTANCE	DIRECTION	NEAREST TOWN	
<i>4</i> Miles	<i>North</i>	<i>Long Beach</i>	
OTHER LANDMARK			
WELL PURPOSE: <input checked="" type="radio"/> Home, <input type="radio"/> Irrigation, <input type="radio"/> Municipal, <input type="radio"/> Industrial, <input type="radio"/> Fish Pond, etc.			

<b>PUMP DATA</b>		
PUMP TYPE (Circle One): Submersible, Turbine, <input checked="" type="radio"/> Jet, <input type="radio"/> Flowing Well, Other (Describe) _____		
POWER TYPE (Circle One): <input checked="" type="radio"/> Electric, <input type="radio"/> Tractor, <input type="radio"/> Diesel, <input type="radio"/> Gasoline, <input type="radio"/> Butane, Other (Describe) _____		
Pump Capacity (GPM) <i>12</i>	No. of Stages <i>2</i>	Setting Depth <i>60'</i> FT.
PUMP TEST		
Well yielded <i>20</i> GPM with a drawdown of <i>10</i> ft. after <i>1</i> hours of pumping		

<b>WELL DATA</b>		
Well Depth <i>580</i>	Casing Diameter (In.) <i>2"</i>	Casing Length (Ft.) <i>570</i>
Type of Casing <i>PVC</i>	Hole Depth <i>580</i>	Depth to Static Water Level <i>40'</i>
TYPE OF COMPLETION: (Circle One or More): <input checked="" type="radio"/> Gravel Packed, <input type="radio"/> Underreamed, <input type="radio"/> Telescoped, <input checked="" type="radio"/> Natural Development, <input type="radio"/> Open Hole, <input type="radio"/> Other		
Top of Lap Pipe or Reduction in Casing		
FEET	IF TELESCOPED OR MORE THAN ONE SCREEN: USE BACK PAGE	

<b>LOG DATA</b>	
TYPE OF LOG RUN (Circle One): No Log Run, Electric, Gamma Ray, Density, Sonic, Neutron, Other (Describe) _____	
Name of Organization Running Log	

<b>SCREEN DATA</b>		
Diameter - Inches <i>2"</i>	Length - Feet <i>10'</i>	Slot Size - Inches <i>.0006</i>
Screen Type <i>PVC</i>	Depth to Bottom - Feet <i>580'</i>	

<b>GEOLOGIC DATA (Office Use Only)</b>			
Surface Elev.	Geologic Unit	Unit Thickness	Depth to Top
Subs. SWL	Date	Analysis	Aquifer Test


Driller's Remarks

DESCRIPTION OF FORMATIONS ENCOUNTERED	FROM	TO
<i>mud</i>	<i>0</i>	<i>160</i>
<i>sand</i>	<i>160</i>	<i>200</i>
<i>mud</i>	<i>200</i>	<i>530</i>
<i>sand</i>	<i>530</i>	<i>580</i>

<b>RECEIVED</b>	
<b>MAY 24 1989</b>	
Department of Natural Resources Bureau of Land & Water Resources	
IF MORE SPACE IS NEEDED, USE BACK	

If well telescopes please sketch and show depths.

GROUND LEVEL

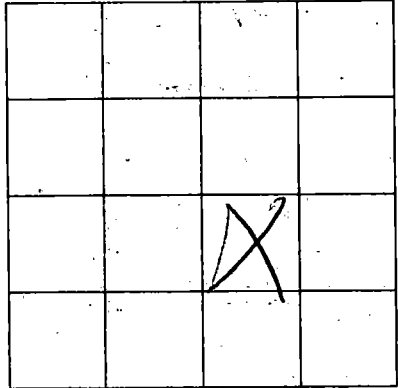

SECTION \_\_\_\_\_

Please indicate well location X.

ADDITIONAL INFORMATION

If more than one screen,  
show location of each on sketch.