

MISSISSIPPI DEPARTMENT OF NATURAL RESOURCES
Bureau of Land and Water Resources

P.O. Box 10631
Jackson, Mississippi 39209
WATER WELL DRILLERS LOG

COUNTY WELL LOCATED <i>Harrison</i>	
WELL NUMBER <i>K 2117</i>	CODED
DATE WELL COMPLETED <i>Nov-22-88</i>	

PERMIT NUMBER <i>0239</i>
NAME OF DRILLING FIRM <i>McBill Pump & Wells</i>

NAME & MAILING ADDRESS OF LANDOWNER <i>Diki Noyantian</i>			
<i>Daugherty Rd.</i>			
<i>Long Beach MS</i>			
WELL LOCATION:	SEC <i>34</i>	TOWNSHIP <i>7 N</i>	RANGE <i>12 E</i>
DISTANCE <i>6</i> Miles	DIRECTION <i>n/w</i>	NEAREST TOWN <i>Long Beach</i>	
OTHER LANDMARK			
WELL PURPOSE: <input checked="" type="checkbox"/> Home <input type="checkbox"/> Irrigation, <input type="checkbox"/> Municipal, <input type="checkbox"/> Industrial, <input type="checkbox"/> Fish Pond, etc.			

PUMP DATA		
PUMP TYPE (Circle One): Submersible, Turbine, <input checked="" type="radio"/> <i>Jet</i> Flowing Well, Other (Describe) _____		
POWER TYPE (Circle One): <input checked="" type="radio"/> <i>Electric</i> , Tractor, Diesel, Gasoline, Butane, Other (Describe) _____		
Pump Capacity (GPM) <i>12</i>	No. of Stages <i>2</i>	Setting Depth <i>400'</i> FT.
PUMP TEST		
Well yielded <i>20</i> GPM with a drawdown of <i>10</i> ft. after <i>1</i> hours of pumping		

WELL DATA		
Well Depth <i>540'</i>	Casing Diameter (In.) <i>2"</i>	Casing Length (Ft.) <i>530</i>
Type of Casing <i>PVC</i>	Hole Depth <i>540</i>	Depth to Static Water Level <i>40'</i>
TYPE OF COMPLETION: (Circle One or More): <input checked="" type="checkbox"/> Gravel Packed, <input type="checkbox"/> Underreamed, <input type="checkbox"/> Telescoped, <input checked="" type="checkbox"/> Natural Development, <input type="checkbox"/> Open Hole, <input type="checkbox"/> Other		
Top of Lap Pipe or Reduction in Casing		
FEET	IF TELESCOPED OR MORE THAN ONE SCREEN: USE BACK PAGE	

LOG DATA	
TYPE OF LOG RUN (Circle One): Electric, Gamma Ray, Density, Sonic, <input checked="" type="radio"/> <i>No Log Run</i> , Other (Describe) _____	
Name of Organization Running Log	

SCREEN DATA		
Diameter - Inches <i>2"</i>	Length - Feet <i>10'</i>	Slot Size - Inches <i>.0006</i>
Screen Type <i>PVC</i>	Depth to Bottom - Feet <i>540'</i>	


GEOLOGIC DATA (Office Use Only)			
Surface Elev.	Geologic Unit	Unit Thickness	Depth to Top
Subs. SWL	Date	Analysis	Aquifer Test
Driller's Remarks			

DESCRIPTION OF FORMATIONS ENCOUNTERED	FROM	TO	FORMATIONS (Continued)	FROM	TO
<i>mud</i>	<i>0</i>	<i>10</i>	RECEIVED MAY 24 1989 Department of Natural Resources Bureau of Land & Water Resources		
<i>sand</i>	<i>10</i>	<i>20</i>			
<i>mud</i>	<i>20</i>	<i>240</i>			
<i>sand</i>	<i>240</i>	<i>260</i>			
<i>mud</i>	<i>260</i>	<i>350</i>			
<i>sand</i>	<i>350</i>	<i>380</i>			
<i>mud</i>	<i>380</i>	<i>500</i>			
<i>sand</i>	<i>500</i>	<i>540</i>			

IF MORE SPACE IS NEEDED, USE BACK

If well telescopes please
sketch and show depths.

GROUND LEVEL

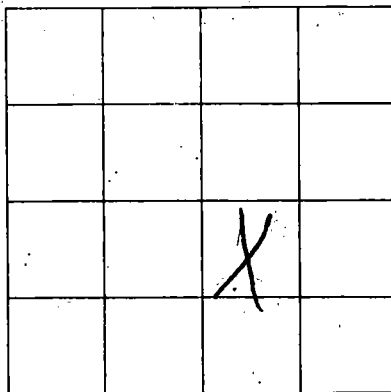

SECTION _____

Please indicate well location X.

ADDITIONAL INFORMATION

Lined area for additional information.

If more than one screen,
show location of each on sketch.