

MISSISSIPPI DEPARTMENT OF NATURAL RESOURCES

Bureau of Land and Water Resources

COUNTY WELL LOCATED Harrison	
WELL NUMBER R	CODED
2128	
DATE WELL COMPLETED 3-20-90	

PERMIT NUMBER 0-239
NAME OF DRILLING FIRM McNeil

P.O. Box 10631
Jackson, Mississippi 39209
WATER WELL DRILLERS LOG

NAME & MAILING ADDRESS OF LANDOWNER Beatline Nursery Beatline Rd.		
WELL LOCATION: SEC 33 TOWNSHIP 7 N S RANGE 12 E W		
DISTANCE B Miles	DIRECTION W	NEAREST TOWN 28th
OTHER LANDMARK		
WELL PURPOSE: Home, Irrigation, Municipal, Industrial, Fish Pond, etc. home		

PUMP DATA		
PUMP TYPE (Circle One): <input checked="" type="radio"/> Submersible , Turbine, Jet, Flowing Well, Other (Describe) _____		
POWER TYPE (Circle One): <input checked="" type="radio"/> Electric , Tractor, Diesel, Gasoline, Butane, Other (Describe) _____		
Pump Capacity (GPM) 18	No. of Stages 14	Setting Depth 80 FT.
PUMP TEST Well yielded 18 GPM with a drawdown of _____ ft. after 1 hours of pumping		

WELL DATA		
Well Depth 440'	Casing Diameter (In.) 4" x 2"	Casing Length (Ft.) 420'
Type of Casing PVC	Hole Depth 440'	Depth to Static Water Level 40'
TYPE OF COMPLETION: (Circle One or More): Gravel Packed, Underreamed, Telescoped, Natural Development, Open Hole, Other (Describe) _____		
Top of Lap Pipe or Reduction in Casing FEET <input type="checkbox"/> IF TELESCOPED OR MORE THAN ONE SCREEN: USE BACK PAGE		

LOG DATA	
TYPE OF LOG RUN (Circle One): Electric, Gamma Ray, Density, Sonic, <input checked="" type="radio"/> No Log Run , Neutron, Other (Describe) _____	
Name of Organization Running Log	


SCREEN DATA		
Diameter - Inches 2	Length - Feet 20	Slot Size - Inches .0006
Screen Type Sch 40 PVC		Depth to Bottom - Feet 440'

GEOLOGIC DATA (Office Use Only)			
Surface Elev.	Geologic Unit	Unit Thickness	Depth to Top
Subs. SWL	Date	Analysis	Aquifer Test
Driller's Remarks			

DESCRIPTION OF FORMATIONS ENCOUNTERED	FROM	TO
mud, sand	0	40
mud	40	60
mud, sand	60	100
sand, mud	100	120
mud	120	220
sand	220	240
mud	240	360
mud, sand	360	400
sand	400	440

FORMATIONS (Continued)	FROM	TO
RECEIVED		
AUG 24 1990		
Department of Natural Resources Bureau of Land & Water Resources		
IF MORE SPACE IS NEEDED, USE BACK		

If well telescopes please sketch and show depths.

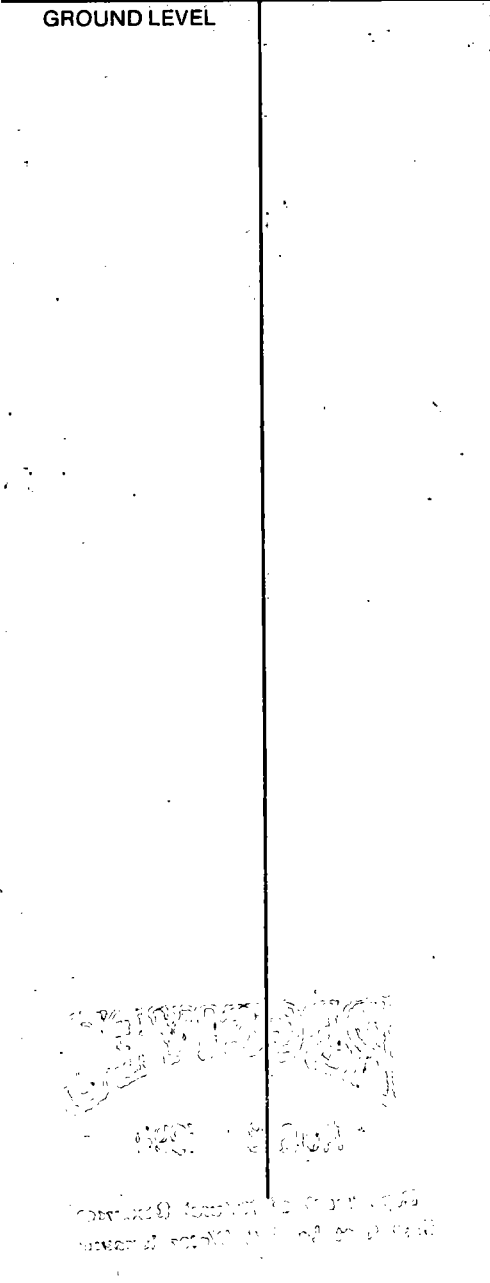

SECTION _____

Please indicate well location X.

ADDITIONAL INFORMATION

If more than one screen, show location of each on sketch.