

MISSISSIPPI DEPARTMENT OF NATURAL RESOURCES

Bureau of Land and Water Resources

P.O. Box 10631

Jackson, Mississippi 39209

WATER WELL DRILLERS LOG

COUNTY WELL LOCATED Harrison	
WELL NUMBER K	CODED
2131	
DATE WELL COMPLETED Oct. 12 1989	

PERMIT NUMBER 0239
NAME OF DRILLING FIRM McMill Pump & Wells

NAME & MAILING ADDRESS OF LANDOWNER Joe Hallowsy D. Herd Rd. Mulport Mrs.			
WELL LOCATION	SEC	TOWNSHIP	RANGE
	10	7 N 12 E	
DISTANCE	DIRECTION	NEAREST TOWN	
2 Miles	North	Long Beach	
OTHER LANDMARK			
WELL PURPOSE: <input checked="" type="checkbox"/> Home, <input type="checkbox"/> Irrigation, <input type="checkbox"/> Municipal, <input type="checkbox"/> Industrial, <input type="checkbox"/> Fish Pond, etc.			

PUMP DATA		
PUMP TYPE (Circle One): <input checked="" type="checkbox"/> Submersible, <input type="checkbox"/> Turbine, <input type="checkbox"/> Jet <input type="checkbox"/> Flowing Well, Other (Describe) _____		
POWER TYPE (Circle One): <input checked="" type="checkbox"/> Electric, <input type="checkbox"/> Tractor, <input type="checkbox"/> Diesel, <input type="checkbox"/> Gasoline, <input type="checkbox"/> Butane, Other (Describe) _____ H/P _____		
Pump Capacity (GPM)	No. of Stages	Setting Depth
78	14	147' FT.
PUMP TEST		
Well yielded 18 GPM with a drawdown of 20 ft. after 1 hours of pumping		

WELL DATA		
Well Depth 560'	Casing Diameter (In.) 4" x 2"	Casing Length (Ft.) 20'
Type of Casing PUC	Hole Depth 560'	Depth to Static Water Level 90'
TYPE OF COMPLETION: (Circle One or More): <input checked="" type="checkbox"/> Gravel Packed, <input type="checkbox"/> Underreamed, <input type="checkbox"/> Telescoped, <input checked="" type="checkbox"/> Natural Development, <input type="checkbox"/> Open Hole, <input type="checkbox"/> Other (Describe) _____		
Top of Lap Pipe or Reduction in Casing FEET IF TELESCOPED OR MORE THAN ONE SCREEN: USE BACK PAGE		

LOG DATA	
TYPE OF LOG RUN (Circle One): <input checked="" type="checkbox"/> Electric, <input type="checkbox"/> Gamma Ray, <input type="checkbox"/> Density, <input type="checkbox"/> Sonic, <input type="checkbox"/> Neutron, Other (Describe) _____ <input checked="" type="checkbox"/> No Log Run	
Name of Organization Running Log	

SCREEN DATA		
Diameter - Inches 2"	Length - Feet 20'	Slot Size - Inches 10006
Screen Type PUC	Depth to Bottom - Feet 560'	


GEOLOGIC DATA (Office Use Only)			
Surface Elev.	Geologic Unit	Unit Thickness	Depth to Top
Subs. SWL	Date	Analysis	Aquifer Test
Driller's Remarks			

DESCRIPTION OF FORMATIONS ENCOUNTERED	FROM	TO
mud	0	60
sand	60	190
mud	190	260
sand	260	290
mud	290	300
sand	500	560

FORMATIONS (Continued)	FROM	TO
RECEIVED		
AUG 16 1990		
Department of Natural Resources Bureau of Land & Water Resources		
IF MORE SPACE IS NEEDED, USE BACK		

If well telescopes please sketch and show depths.

GROUND LEVEL

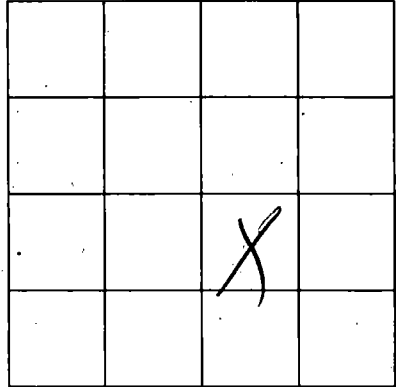

SECTION _____

Please indicate well location X.

ADDITIONAL INFORMATION

200'-4" PVC

300'-2" PVC

If more than one screen,
show location of each on sketch.