

MISSISSIPPI DEPARTMENT OF NATURAL RESOURCES

Bureau of Land and Water Resources

P.O. Box 10631

Jackson, Mississippi 39209

WATER WELL DRILLERS LOG

COUNTY WELL LOCATED Harrison	
WELL NUMBER 12	CODED
2132	
DATE WELL COMPLETED Aug. 3-1989	

PERMIT NUMBER 0239
NAME OF DRILLING FIRM Maxill Pump & Wells

NAME & MAILING ADDRESS OF LANDOWNER Mary Crose Big Creek rd. Hurst, Ms.		
WELL LOCATION: SEC	TOWNSHIP	RANGE
35	7 N	12 E
DISTANCE	DIRECTION	NEAREST TOWN
6 Miles	west of	Hulspart
OTHER LANDMARK		
WELL PURPOSE: <input checked="" type="checkbox"/> Home Irrigation, <input type="checkbox"/> Municipal, <input type="checkbox"/> Industrial, <input type="checkbox"/> Fish Pond, etc.		

PUMP DATA		
PUMP TYPE (Circle One): Submersible, Turbine, <input checked="" type="radio"/> Jet, <input type="radio"/> Flowing Well, Other (Describe) _____		
POWER TYPE (Circle One): <input checked="" type="radio"/> Electric, <input type="radio"/> Tractor, <input type="radio"/> Diesel, <input type="radio"/> Gasoline, <input type="radio"/> Butane, Other (Describe) _____ H/P _____		
Pump Capacity (GPM)	No. of Stages	Setting Depth
11	2	60' FT.
PUMP TEST		
Well yielded 11 GPM with a drawdown of 10 ft. after 1 hours of pumping		

WELL DATA		
Well Depth 500'	Casing Diameter (In.) 2"	Casing Length (Ft.) 30'
Type of Casing PVC	Hole Depth 500'	Depth to Static Water Level 40'
TYPE OF COMPLETION: (Circle One or More): <input checked="" type="checkbox"/> Gravel Packed, <input type="checkbox"/> Underreamed, <input type="checkbox"/> Telescoped, <input checked="" type="checkbox"/> Natural Development, <input type="checkbox"/> Open Hole, <input type="checkbox"/> Other (Describe) _____		
Top of Lap Pipe or Reduction in Casing		
FEET	IF TELESCOPED OR MORE THAN ONE SCREEN: USE BACK PAGE	

LOG DATA	
TYPE OF LOG RUN (Circle One): Electric, Gamma Ray, Density, Sonic, Neutron, Other (Describe) _____	
<input checked="" type="radio"/> No Log Run	
Name of Organization Running Log	

SCREEN DATA		
Diameter - Inches 2"	Length - Feet 10'	Slot Size - Inches .0006
Screen Type PVC	Depth to Bottom - Feet 500'	


GEOLOGIC DATA (Office Use Only)			
Surface Elev.	Geologic Unit	Unit Thickness	Depth to Top
Subs. SWL	Date	Analysis	Aquifer Test
Driller's Remarks			

DESCRIPTION OF FORMATIONS ENCOUNTERED	FROM	TO	FORMATIONS (Continued)
mud	0	190	<div style="font-size: 2em; font-weight: bold; opacity: 0.5;">RECEIVED</div> <div style="font-size: 1.5em; font-weight: bold; margin-top: 10px;">AUG 16 1990</div> <div style="font-size: 0.8em; margin-top: 10px;"> Department of Natural Resources Bureau of Land & Water Resources </div>
sand	190	210	
mud	210	470	
sand	470	500	

IF MORE SPACE IS NEEDED, USE BACK

If well telescopes please sketch and show depths.

GROUND LEVEL

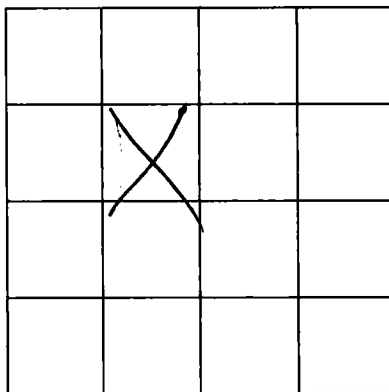

SECTION _____

Please indicate well location X.

ADDITIONAL INFORMATION

If more than one screen,
show location of each on sketch.