

MISSISSIPPI DEPARTMENT OF NATURAL RESOURCES

Bureau of Land and Water Resources

P.O. Box 10631
Jackson, Mississippi 39209
WATER WELL DRILLERS LOG

COUNTY WELL LOCATED <u>Harrison</u>	
WELL NUMBER <u>K</u>	CODED
<u>2133</u>	
DATE WELL COMPLETED <u>June 16-89</u>	

PERMIT NUMBER <u>0239</u>
NAME OF DRILLING FIRM <u>McNeil Pump & Well</u>

NAME & MAILING ADDRESS OF LANDOWNER <u>Virginia Boyd</u> <u>Paula dr</u> <u>Long Beach ms.</u>			
WELL LOCATION	SEC	TOWNSHIP	RANGE
	<u>35</u>	<u>7 N</u>	<u>12 E</u>
DISTANCE	DIRECTION	NEAREST TOWN	
<u>1</u> Miles	<u>East</u> of <u>Long Beach</u>		
OTHER LANDMARK			
WELL PURPOSE: <input checked="" type="checkbox"/> Home, <input type="checkbox"/> Irrigation, <input type="checkbox"/> Municipal, <input type="checkbox"/> Industrial, <input type="checkbox"/> Fish Pond, etc.			

PUMP DATA		
PUMP TYPE (Circle One): Submersible, Turbine, <input checked="" type="radio"/> Jet, Flowing Well, Other (Describe) _____		
POWER TYPE (Circle One): <input checked="" type="radio"/> Electric, Tractor, Diesel, Gasoline, Butane, Other (Describe) _____ H/P _____		
Pump Capacity (GPM)	No. of Stages	Setting Depth
<u>12</u>	<u>2</u>	<u>40'</u> FT.
PUMP TEST		
Well yielded <u>12</u> GPM with a drawdown of <u>10</u> ft. after <u>1</u> hours of pumping		

WELL DATA		
Well Depth	Casing Diameter (In.)	Casing Length (Ft.)
<u>220</u>	<u>2"</u>	<u>20'</u>
Type of Casing	Hole Depth	Depth to Static Water Level
<u>PVC</u>	<u>220'</u>	<u>20'</u>
TYPE OF COMPLETION: (Circle One or More): Gravel Packed, Underreamed, Telescoped, Natural Development, Open Hole, Other (Describe) _____		
Top of Lap Pipe or Reduction in Casing		
FEET <input type="checkbox"/> IF TELESCOPED OR MORE THAN ONE SCREEN: USE BACK PAGE		

LOG DATA	
TYPE OF LOG RUN (Circle One): <input checked="" type="radio"/> No Log Run Electric, Gamma Ray, Density, Sonic, Neutron, Other (Describe) _____	
Name of Organization Running Log	

SCREEN DATA		
Diameter - Inches	Length - Feet	Slot Size - Inches
<u>2"</u>	<u>10'</u>	<u>.0006</u>
Screen Type	Depth to Bottom - Feet	
<u>PVC</u>	<u>220'</u>	

GEOLOGIC DATA (Office Use Only)			
Surface Elev.	Geologic Unit	Unit Thickness	Depth to Top
Subs. SWL	Date	Analysis	Aquifer Test
Driller's Remarks			

DESCRIPTION OF FORMATIONS ENCOUNTERED	FROM		TO	
	FROM	TO	FROM	TO
<u>Sand</u>	<u>0</u>	<u>60</u>		
<u>mud</u>	<u>60</u>	<u>170</u>		
<u>Sand</u>	<u>170</u>	<u>220</u>		

RECEIVED


AUG 16 1990

Department of Natural Resources
Bureau of Land & Water Resources

IF MORE SPACE IS NEEDED, USE BACK

If well telescopes please sketch and show depths.

GROUND LEVEL

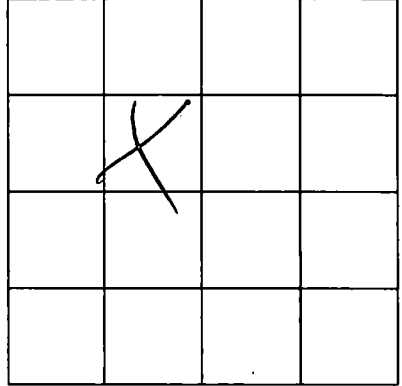

SECTION _____

Please indicate well location X.

ADDITIONAL INFORMATION

If more than one screen,
show location of each on sketch.