

**MISSISSIPPI DEPARTMENT OF NATURAL RESOURCES**  
Bureau of Land and Water Resources

P.O. Box 10631

Jackson, Mississippi 39209

**WATER WELL DRILLERS LOG**

COUNTY WELL LOCATED <i>N Harrison</i>	
WELL NUMBER <i>R 2147</i>	CODED
DATE WELL COMPLETED <i>8/11/88</i>	

PERMIT NUMBER
<b>Coastal Drilling &amp; Service Co.</b> 8456 Woolmarket Biloxi Road Biloxi, Mississippi 39532

NAME & MAILING ADDRESS OF LANDOWNER <i>Kenneth Hardy</i> <i>Roberson Rd &amp; County Road</i> <i>Gulfport, Ms.</i>			
WELL LOCATION <i>Harrison</i>	SEC <i>3</i>	TOWNSHIP <i>7</i>	RANGE <i>12</i>
DISTANCE <i>3</i> Miles	DIRECTION <i>NW</i>	NEAREST TOWN <i>Landon</i>	
OTHER LANDMARK <i>3 miles N of LTD</i>			
WELL PURPOSE: Home, Irrigation, Municipal, Industrial, Fish Pond, etc. <i>None</i>			

PUMP DATA		
PUMP TYPE (Circle One): Submersible, Turbine, <input checked="" type="radio"/> Jet, Flowing Well, Other (Describe) _____		
POWER TYPE (Circle One): <input checked="" type="radio"/> Electric, Tractor, Diesel, Gasoline, Butane, Other (Describe) _____		
Pump Capacity (GPM) <i>10</i>	No. of Stages <i>2</i>	Setting Depth <i>60</i> FT.
PUMP TEST Well yielded <i>10</i> GPM with a drawdown of <i>0</i> ft. after <i>6</i> hours of pumping		

WELL DATA		
Well Depth <i>237'</i>	Casing Diameter (In.) <i>2"</i>	Casing Length (Ft.) <i>227'</i>
Type of Casing <i>PVC</i>	Hole Depth <i>237'</i>	Depth to Static Water Level <i>45'</i>
TYPE OF COMPLETION: (Circle One or More): <input checked="" type="checkbox"/> Gravel Packed, <input type="checkbox"/> Underreamed, <input type="checkbox"/> Telescoped, <input checked="" type="checkbox"/> Natural Development, <input type="checkbox"/> Open Hole, <input type="checkbox"/> Other (Describe) _____		
Top of Lap Pipe or Reduction in Casing FEET <input type="checkbox"/> IF TELESCOPED OR MORE THAN ONE SCREEN: USE BACK PAGE		

LOG DATA	
TYPE OF LOG RUN (Circle One): No Log Run, Electric, Gamma Ray, Density, Sonic, Neutron, Other (Describe) _____	
Name of Organization Running Log	

SCREEN DATA		
Diameter - Inches <i>2"</i>	Length - Feet <i>10</i>	Slot Size - Inches <i>.008</i>
Screen Type <i>PVC</i>	Depth to Bottom - Feet <i>237'</i>	


GEOLOGIC DATA (Office Use Only)			
Surface Elev.	Geologic Unit	Unit Thickness	Depth to Top
Subs. SWL	Date	Analysis	Aquifer Test
Driller's Remarks <i>None</i>			

DESCRIPTION OF FORMATIONS ENCOUNTERED	FROM	TO	FORMATIONS (Continued)	FROM	TO
<i>top soil</i>	<i>1'</i>	<i>3'</i>	<b>RECEIVED</b> FEB 10 1992 Dept. of Environmental Quality Bureau of Land & Water Resources		
<i>Red sand</i>	<i>3'</i>	<i>15'</i>			
<i>White sand</i>	<i>15'</i>	<i>25'</i>			
<i>soft Blue Clay</i>	<i>25'</i>	<i>290'</i>			
<i>fine water sand</i>	<i>290'</i>	<i>230'</i>			
<i>Coarse watersand</i>	<i>230'</i>	<i>237'</i>			

IF MORE SPACE IS NEEDED, USE BACK

If well telescopes please  
sketch and show depths.

GROUND LEVEL

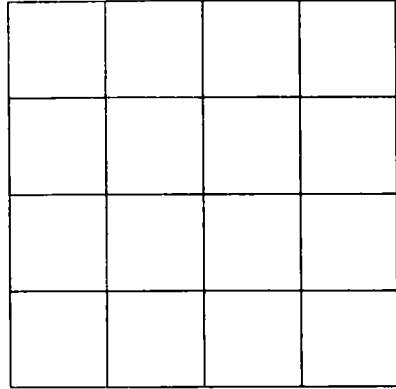

SECTION \_\_\_\_\_

Please indicate well location X.

ADDITIONAL INFORMATION

If more than one screen,  
show location of each on sketch.