

HAR.
 K 2165
 5-18-63

WATER WELL DRILLERS LOG

Date: 5-18, 1963, Driller: C. T. SWITZER WELL CO. County Harrison

(Name)

(1) Owner of Land: John A. and Hulbert, Miss.
 (Name)
John A. and Hulbert, Miss.
 (Address)

(2) Location: 1/4, 1/4, Sec. 7, T. R. 12
 (distance) (direction) (Nearest Town)

(3) Topography: ✓
 (Hilly) (Flat) (Level)

(4) Purpose of Well: Domestic
 (Domestic Irrigation
 Municipal, Industrial, Other)

Description & Color of Materials Sand, Clay, Red Clay, Shell, etc.	Thick- ness Feet	Depth Feet
<u>Clay</u>	<u>80</u>	<u>40</u>
<u>Sand, red</u>	<u>40</u>	<u>100</u>
<u>Clay</u>	<u>100</u>	<u>144</u>
<u>Sand</u>	<u>144</u>	<u>220</u>
<u>Sand, good</u>	<u>220</u>	<u>250</u>

Information upon completion of well:

(1) Diameter 2 inches.

(2) Total Depth 210 feet.

(3) Water Level 41' feet below top of ground.

(4) Cased to 210', Size 2"


(5) Screen: Size 2", Length 10'

(6) Were any formations sealed against pollution?
✓ yes, _____ no.

If YES depth of formation _____

Why Water Dept requirements

Drillers Remarks: _____

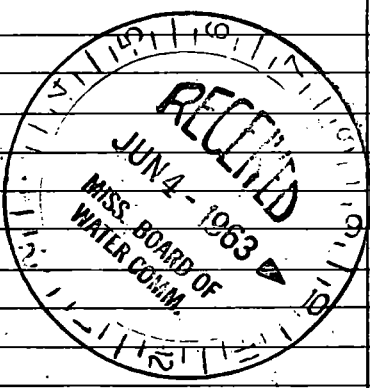

Well No.

(Use Back Side)

