

MISSISSIPPI DEPARTMENT OF NATURAL RESOURCES

Bureau of Land and Water Resources

Southport Mall

P.O. Box 10631

Jackson, Mississippi 39209

WATER WELL DRILLERS LOG

HARRISON
~~K 3122~~
2166

2/25/86 19 Lipman Well Co Harrison
 date well completed firm name county well located

LANDOWNER: Carl Wright
Allen Rd.
Gulfport, Ms 39503
 (mailing address)

description of formations encountered	from	to
Topsoil		6"
Sandy Clay	6"	9"
Sandy Clay	9"	30"
Sandy Clay	30"	112"
Sandy Clay	112"	121"
Sand	121"	210"
	210"	225"

WELL LOCATION:
 sec. 11 T. 7 N R. 12 E
5 miles North of Long Beach
 (distance) (direction) (nearest town)

WELL PURPOSE: Home
 (home, irrigation, municipal, industrial)

WELL COMPLETION DATA:

- (1) diameter (inches) 2"
- (2) total depth (feet) 225'
- (3) static water level (feet) 35 ^{below} above top of ground.
- (4) casing PVC, 215'
 (material) (depth)
2" If telescope see back.
 (size)
- (5) screen 10', 215'
 (length) (depth to top)
2" PVC
 (size) (material)
- (6) pump NA
 (HP) (yield gpm)
 (type power)
- (7) electric log No
 (yes or no)
No
 (organization running log)
- (8) how well bottom plugged Sand
Shack

RECEIVED


OCT 06 1986

Department of Natural Resources
 Bureau of Land & Water Resources

DRILLERS REMARKS:

If well telescopes please sketch and show depths.

GROUND LEVEL

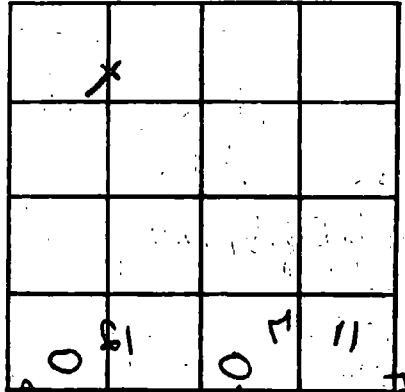

SECTION 11

Please indicate well location X.

ADDITIONAL INFORMATION

320

~~AA~~

If more than one screen, show locations of each on sketch.