

MISSISSIPPI DEPARTMENT OF NATURAL RESOURCES

Bureau of Land and Water Resources

COUNTY WELL LOCATED
HARRISON

WELL NUMBER **2168** CODED **2168**

7-12-90

DATE WELL COMPLETED

PERMIT NUMBER **404**

NAME OF DRILLING FIRM
Lyman Well Co.

Gulfport Ms

P.O. Box 10631
Jackson, Mississippi 39209
WATER WELL DRILLERS LOG

NAME & MAILING ADDRESS OF LANDOWNER
Richard Huffmaster
11253 Allen Road
Gulfport, Ms. 39503

WELL LOCATION: SEC **11** TOWNSHIP **12W** RANGE **7S**

11 **7** **N** **12** **E**
W

DISTANCE _____ DIRECTION _____ NEAREST TOWN _____

Miles _____ of _____

OTHER LANDMARK _____

WELL PURPOSE: Home, Irrigation, Municipal, Industrial, Fish Pond, etc.

PUMP DATA

PUMP TYPE (Circle One):
Submersible, Turbine, **Jet** Flowing Well,
Other (Describe) _____

POWER TYPE (Circle One):
Electric, Tractor, Diesel, Gasoline, Butane,
Other (Describe) _____ H/P **1**

Pump Capacity (GPM) _____ No. of Stages _____ Setting Depth _____ FT.

PUMP TEST

Well yielded _____ GPM with
a drawdown of _____ ft.
after _____ hours of pumping

WELL DATA

Well Depth **236'** Casing Diameter (In.) **2"** Casing Length (Ft.) **226**

Type of Casing **PVC** Hole Depth _____ Depth to Static Water Level _____

TYPE OF COMPLETION: (Circle One or More):
Gravel Packed, Underreamed, Telescoped,
Natural Development, Open Hole, Other
(Describe) _____

Top of Lap Pipe or Reduction in Casing

FEET IF TELESCOPED OR MORE THAN ONE SCREEN: USE BACK PAGE

LOG DATA

TYPE OF LOG RUN (Circle One): **No Log Run**,
Electric, Gamma Ray, Density, Sonic, Neutron,
Other (Describe) _____

Name of Organization Running Log _____

SCREEN DATA

Diameter - Inches **2"** Length - Feet **10** Slot Size - Inches _____

Screen Type **PVC** Depth to Bottom - Feet _____

GEOLOGIC DATA (Office Use Only)

Surface Elev.	Geologic Unit	Unit Thickness	Depth to Top
Subs. SWL	Date	Analysis	Aquifer Test

Driller's Remarks

DESCRIPTION OF FORMATIONS ENCOUNTERED	FROM	TO
top soil	0	3
yellow clay	3	200
sand	200	236

FORMATIONS (Continued)	FROM	TO
RECEIVED		
OCT 23 1990		
Department of Natural Resources Bureau of Land & Water Resources		

IF MORE SPACE IS NEEDED, USE BACK


If well telescopes please sketch and show depths.

GROUND LEVEL

SECTION _____

Please indicate well location X.

ADDITIONAL INFORMATION

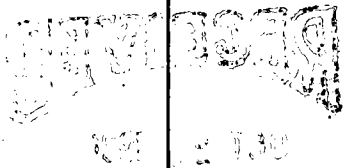

2. LOCATION OF EACH OF THE SCREENS
INDICATED BY 'X' ON SKETCH & DEPTHS?

If more than one screen,
show location of each on sketch.