

**MISSISSIPPI DEPARTMENT OF NATURAL RESOURCES**  
Bureau of Land and Water Resources

P.O. Box 10631

Jackson, Mississippi 39209

**WATER WELL DRILLERS LOG**

COUNTY WELL LOCATED <i>Madison</i>	
WELL NUMBER <i>X 240</i>	CODED <i>226</i>
DATE WELL COMPLETED <i>11-11-88</i>	

PERMIT NUMBER
NAME OF DRILLING FIRM <i>Wood Well Drg</i>
<i>222 By. 350C, B.D.P., Inc.</i>

NAME & MAILING ADDRESS OF LANDOWNER <i>Michelle Watson</i>		
<i>See Haven Rd.</i>		
<i>Pass Christian, ms.</i>		
WELL LOCATION: SEC	TOWNSHIP	RANGE
<i>33</i>	<i>7 N</i>	<i>12 E</i>
DISTANCE	DIRECTION	NEAREST TOWN
<i>4</i> Miles	<i>N</i>	of <i>Oshtemo</i>
OTHER LANDMARK <i>-</i>		
WELL PURPOSE: Home, Irrigation, Municipal, Industrial, Fish Pond, etc. <i>Home</i>		

PUMP DATA		
PUMP TYPE (Circle One): <input checked="" type="checkbox"/> Submersible, <input type="checkbox"/> Turbine, <input type="checkbox"/> Jet, <input type="checkbox"/> Flowing Well, Other (Describe) _____		
POWER TYPE (Circle One): <input checked="" type="checkbox"/> Electric, <input type="checkbox"/> Tractor, <input type="checkbox"/> Diesel, <input type="checkbox"/> Gasoline, <input type="checkbox"/> Butane, Other (Describe) _____		
Pump Capacity (GPM) <i>25</i>	No. of Stages <i>8</i>	Setting Depth <i>100</i> FT.
PUMP TEST		
Well yielded _____ GPM with		
a drawdown of _____ ft.		
after _____ hours of pumping		

WELL DATA		
Well Depth <i>565'</i>	Casing Diameter (In.) <i>4" X 2"</i>	Casing Length (Ft.) <i>545</i>
Type of Casing <i>Sch. 40 PVC</i>	Hole Depth <i>565</i>	Depth to Static Water Level <i>-35'</i>
TYPE OF COMPLETION: (Circle One or More): <input type="checkbox"/> Gravel Packed, <input type="checkbox"/> Underreamed, <input type="checkbox"/> Telescoped, <input type="checkbox"/> Natural Development, <input type="checkbox"/> Open Hole, <input type="checkbox"/> Other (Describe) <i>Backwash - air</i>		
Top of Lap Pipe or Reduction in Casing <i>15 FEET</i> IF TELESCOPED OR MORE THAN ONE SCREEN: USE BACK PAGE		

LOG DATA	
TYPE OF LOG RUN (Circle One): <input type="checkbox"/> Electric, <input type="checkbox"/> Gamma Ray, <input type="checkbox"/> Density, <input type="checkbox"/> Sonic, <input checked="" type="checkbox"/> Neutron, Other (Describe) _____	
Name of Organization Running Log	

SCREEN DATA		
Diameter - Inches <i>2</i>	Length - Feet <i>20</i>	Slot Size - Inches <i>.008</i>
Screen Type <i>Sch. 80 PVC</i>	Depth to Bottom - Feet	


GEOLOGIC DATA (Office Use Only)			
Surface Elev.	Geologic Unit	Unit Thickness	Depth to Top
Subs. SWL	Date	Analysis	Aquifer Test

Driller's Remarks <i>N/A</i>
---------------------------------

DESCRIPTION OF FORMATIONS ENCOUNTERED	FROM	TO	FORMATIONS (Continued)	FROM	TO
<i>Sandy - Soil</i>	<i>0</i>	<i>5</i>	<b>RECEIVED</b>  DEC 16 1988  Department of Natural Resources Bureau of Land & Water Resources		
<i>Clay w/ s.s.</i>	<i>5</i>	<i>86</i>			
<i>Clay - silt</i>	<i>86</i>	<i>240</i>			
<i>fine ss</i>	<i>240</i>	<i>268</i>			
<i>Clay - silt</i>	<i>268</i>	<i>512</i>			
<i>Clay ss</i>	<i>512</i>	<i>565</i>			

IF MORE SPACE IS NEEDED, USE BACK

If well telescopes please sketch and show depths.

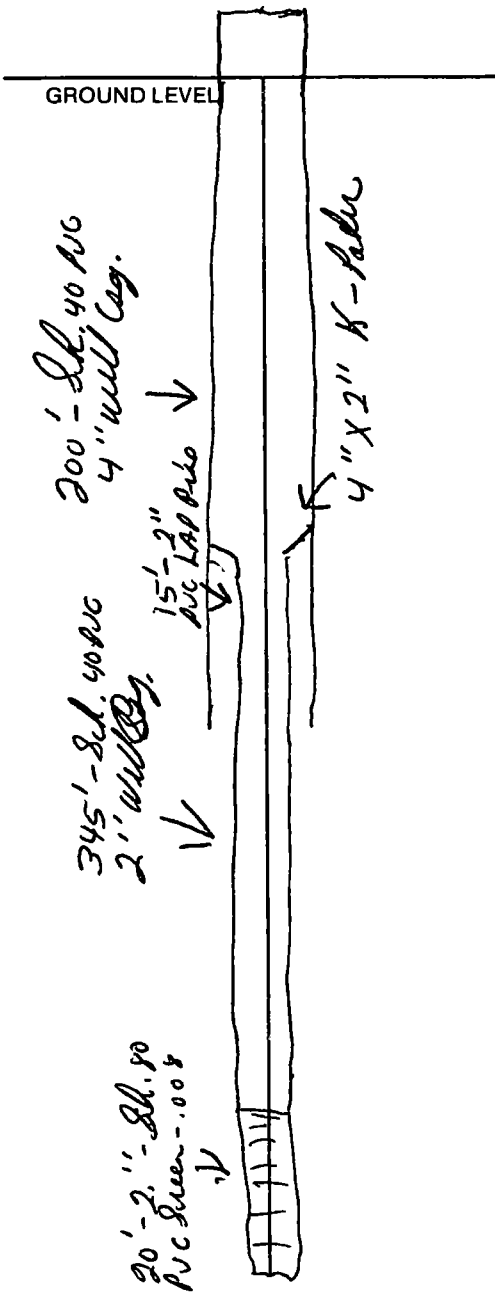

		X	

SECTION 33

Please indicate well location X.

ADDITIONAL INFORMATION

If more than one screen, show location of each on sketch.