

MISSISSIPPI DEPARTMENT OF NATURAL RESOURCES
Bureau of Land and Water Resources

P.O. Box 10631
Jackson, Mississippi 39209
WATER WELL DRILLERS LOG

COUNTY WELL LOCATED Harrison	
WELL NUMBER K 2418	COPED 227
DATE WELL COMPLETED March 6-89	

PERMIT NUMBER 0239
NAME OF DRILLING FIRM McMill Pump
Well

NAME & MAILING ADDRESS OF LANDOWNER Bill Lasher			
11262 Wittmore dr			
St. ms.			
WELL LOCATION:	SEC 11	TOWNSHIP 7	RANGE N 12 E
DISTANCE 4	DIRECTION North	NEAREST TOWN Long Beach	
OTHER LANDMARK			
WELL PURPOSE <input checked="" type="checkbox"/> Home Irrigation, <input type="checkbox"/> Municipal, <input type="checkbox"/> Industrial, <input type="checkbox"/> Fish Pond, etc.			

PUMP DATA		
PUMP TYPE (Circle One): Submersible, Turbine, <input checked="" type="radio"/> Jet Flowing Well, Other (Describe) _____		
POWER TYPE (Circle One): <input checked="" type="radio"/> Electric , Tractor, Diesel, Gasoline, Butane, Other (Describe) _____		
Pump Capacity (GPM) 12	No. of Stages 2	Setting Depth 60' FT.
PUMP TEST		
Well yielded 20 GPM with a drawdown of 10 ft. after 1 hours of pumping		

WELL DATA		
Well Depth 560	Casing Diameter (In.) 2"	Casing Length (Ft.) 550
Type of Casing PVC	Hole Depth 560	Depth to Static Water Level 40'
TYPE OF COMPLETION: (Circle One or More): <input checked="" type="checkbox"/> Natural Development , <input type="checkbox"/> Gravel Packed, <input type="checkbox"/> Underreamed, <input type="checkbox"/> Telescoped, <input type="checkbox"/> Open Hole, <input type="checkbox"/> Other		
Top of Lap Pipe or Reduction in Casing FEET IF TELESCOPED OR MORE THAN ONE SCREEN: USE BACK PAGE		

LOG DATA	
TYPE OF LOG RUN (Circle One): Electric, Gamma Ray, Density, Sonic, <input checked="" type="radio"/> No Log Run , Other (Describe) Neutron	
Name of Organization Running Log	

SCREEN DATA		
Diameter - Inches 2"	Length - Feet 10'	Slot Size - Inches .0006
Screen Type PVC	Depth to Bottom - Feet 560	


GEOLOGIC DATA (Office Use Only)			
Surface Elev.	Geologic Unit	Unit Thickness	Depth to Top
Subs. SWL	Date	Analysis	Aquifer Test
Driller's Remarks			

DESCRIPTION OF FORMATIONS ENCOUNTERED	FROM	TO
mud	0	20
sand	20	60
mud	60	200
sand	200	280
mud	280	450
sand	450	560

RECEIVED	
MAY 24 1989	
Department of Natural Resources Bureau of Land & Water Resources	
IF MORE SPACE IS NEEDED, USE BACK	

If well telescopes please sketch and show depths.

GROUND LEVEL

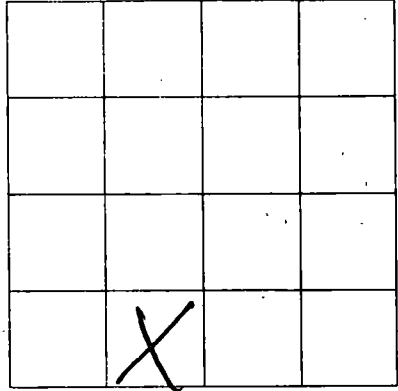

SECTION _____

Please indicate well location X.

ADDITIONAL INFORMATION

If more than one screen,
show location of each on sketch.