

MISSISSIPPI DEPARTMENT OF ENVIRONMENTAL QUALITY

Office of Land and Water Resources

P. O. Box 10631
Jackson, MS 39289-0631

WATER WELL DRILLERS LOG

COUNTY WELL LOCATED <u>Harrison</u>	
WELL NUMBER <u>K-2230</u>	CODED
DATE WELL COMPLETED <u>9/07/99</u>	

PERMIT NUMBER <u>0-239</u>
NAME OF DRILLING FIRM <u>Mr. Bill Puff 1</u>
<u>well</u>

NAME & MAILING ADDRESS OF LANDOWNER <u>minnie Tucker</u>			
WELL LOCATION <u>Long Beach, MS</u>			
SEC <u>33</u>	TOWNSHIP <u>7 N</u>	RANGE <u>12 E</u>	W
DISTANCE _____ Miles	DIRECTION	NEAREST TOWN	
OTHER LANDMARK			
WELL PURPOSE <input checked="" type="checkbox"/> Home Irrigation, Municipal, Industrial, Fish Pond, etc.			

PUMP DATA			
PUMP TYPE (Circle One): <input checked="" type="checkbox"/> Submersible Turbine Jet Flowing Well. Other (Describe) _____			
POWER TYPE (Circle One): <input checked="" type="checkbox"/> Electric Tractor Diesel Gasoline Butane. Other (Describe) _____ H/P <u>1</u>			
Pump Capacity (GPM) <u>18</u>	No. of Stages <u>9</u>	Setting Depth <u>100</u> FT.	
PUMP TEST			
Well yielded <u>18</u> GPM with a drawdown of <u>5</u> ft. after <u>5</u> hours of pumping			

WELL DATA		
Well Depth <u>400</u>	Casing Diameter (In) <u>4 X 2</u>	Casing Length (Ft) <u>350</u> <u>440</u>
Type of Casing <u>PVC</u>	Hole Depth <u>400</u>	Depth to Static Water Level <u>60</u>
TYPE OF COMPLETION: (Circle One or More): <input checked="" type="checkbox"/> Gravel Packed, <input type="checkbox"/> Underreamed, <input type="checkbox"/> Telescoped, <input checked="" type="checkbox"/> Natural Development, <input type="checkbox"/> Open Hole, <input type="checkbox"/> Other (Describe) _____		
WELL GROUTED TO A DEPTH OF <u>10</u> FEET Type Grout (circle one): Cement, Bentonite, or Mix		

LOG DATA	
TYPE OF LOG RUN (Circle One): <input type="checkbox"/> No Log Run, <input type="checkbox"/> Electric, <input type="checkbox"/> Gamma Ray, <input type="checkbox"/> Density, <input type="checkbox"/> Sonic, <input type="checkbox"/> Neutron, <input checked="" type="checkbox"/> Other (Describe) <u>Hand written</u>	
Name of Organization Running Log	

SCREEN DATA		
Diameter - Inches <u>2 1/2"</u>	Length - Feet <u>20</u>	Slot Size - Inches <u>.006</u>
Screen Type <u>PVC</u>	Depth to Bottom - Feet <u>400</u>	

GEOLOGIC DATA (Office Use Only)			
Surface Elev.	Geologic Unit	Unit Thickness	Depth to Top
Subs SWL	Date	Analysis	Aquifer Test
Driller's Remarks			
Top of Lap Pipe or Reduction in Casing -			
FEET		IF TELESCOPED OR MORE THAN ONE SCREEN, USE BACK PAGE	

DESCRIPTION OF FORMATIONS ENCOUNTERED	FROM	TO
sand	0	20
mud	40	160
sand	160	200
mud	200	340
sand	340	400


FORMATIONS (Continued)	FROM	TO
sand	0	20
mud	40	160
sand	160	200
mud	200	360
sand	360	400

REC'D JUN 25 2001

IF MORE SPACE IS NEEDED USE BACK

If well telescopes please
sketch and show depths.

GROUND LEVEL

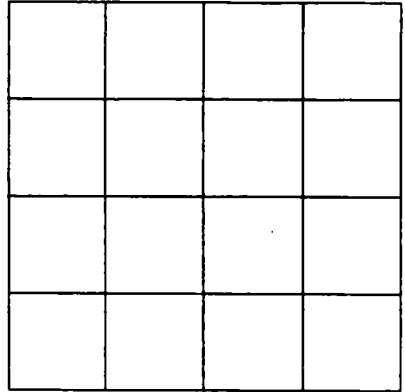

SECTION _____

Please indicate well location X.

ADDITIONAL INFORMATION

If more than one screen,
show location of each on sketch.