

HAR,
K

WATER WELL DRILLERS LOG


K

8-6-60

Date: 8-6, 1960, Driller: Sutton Well Works County Harrison

(Name)

	Description & Color of Materials Sand, Clay, Red Clay, Shell, etc.	Thick- ness Feet	Depth Feet
(1) Owner of Land: <u>H. T. POOLE</u> (Name)	<u>Driskel sand-clay</u> <u>Clay</u> <u>sand</u>	<u>28</u> <u>115</u> <u>40</u>	<u>28</u> <u>143</u> <u>183</u>
<u>RT. 2 GULFPORT, MISS.</u> (Address)			
(2) Location: _____ <u>8</u> miles <u>N</u> of <u>GULFPORT</u> , (distance) (direction) (Nearest Town)			
(3) Topography: <u>Hilly</u> (Hilly) (Flat) (Level)			
(4) Purpose of Well: <u>domestic</u> (Domestic Irrigation Municipal, Industrial, Other)			
Information upon completion of well:			
(1) Diameter <u>2</u> inches.			
(2) Total Depth <u>183</u> feet.			
(3) Water Level <u>26</u> feet below top of ground.			
(4) Cased <u>to all</u> , Size <u>2"</u>			
(5) Screen: Size <u>2"</u> , Length <u>5'</u>			
(6) Were any formations sealed against pollution? <u>no</u>			
If YES depth of formation _____			
Why _____			
Drillers Remarks: _____			

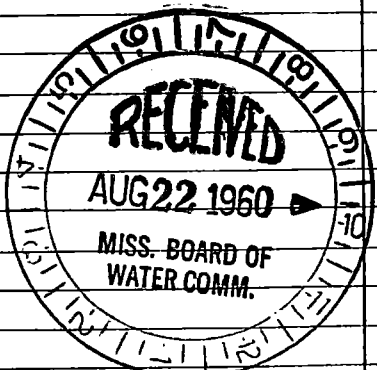

(Use Back Side)

Well No.

