

HAR.

MISSISSIPPI BOARD OF WATER COMMISSIONERS

K.

WATER WELL DRILLERS LOG

K-300

10-10-61

Date: 10-10, 1961, Driller: J. Beard County Harrison

(Name)

(1) Owner of Land: Pat Howard (Name)

Rt 1 Bx 145-C Sulphur in (Address)

(2) Location: 1/4, 1/4, Sec. T R

8 miles North of Sulphur (distance) (direction) (Nearest town)

(3) Topography: X (Hilly) (Flat) (Level)

(4) Purpose of Well: Home use (Domestic Irrigation Municipal, Industrial, Other)

Description & Color of Materials Sand, Clay, Red Clay, Shell, etc.	Thick- ness Feet	Depth Feet
white sand & mud	60	60
mud soft	24	84
Hard Blue Mud	20	104
art sand	58	162
Total Depth		162

Information upon completion of well:

(1) Diameter 2" x 1/4" inches.

(2) Total Depth 162 feet.

(3) Water Level 22 feet below top of ground.

(4) Cased to, Size


(5) Screen: Size 1 1/4" Length 10 ft

(6) Were any formations sealed against pollution? yes, no.

If YES depth of formation

Why

Drillers Remarks:

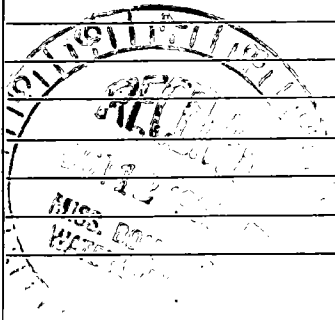

(Use Back Side)

Well No.

CONFIDENTIAL - SECURITY INFORMATION

[The following text is extremely faint and illegible due to the quality of the scan. It appears to be a multi-paragraph document with various lines of text, possibly containing sensitive information as indicated by the header.]