

HAR.

MISSISSIPPI BOARD OF WATER COMMISSIONERS

E 450409

4-1-61 K-174 WATER WELL DRILLERS LOG

CODED

312

Date: 4-1, 1961, Driller: J.B.

County Harrison

(Name)

(1) Owner of Land: Nicholas Ledner

(Name)

Rt 1 Pass Christian

(Address)

(2) Location: 1/4, 1/4, Sec. 9 T 2 R 12

5 miles North of Delisle
(distance) (direction) (Nearest Town)

(3) Topography: (Hilly) (Flat) (Level)

(4) Purpose of Well: Home use
(Domestic Irrigation, Municipal, Industrial, Other)

Description & Color of Materials
Sand, Clay, Red Clay, Shell, etc.

Thick-
ness
Feet

Depth
Feet

Red Clay & sand
Blue Clay
Strata

0
42
95
20
157

Information upon completion of well:

- (1) Diameter: 2 1/4 inches.
- (2) Total Depth: 157 feet.
- (3) Water Level: 30' feet below top of ground.
- (4) Cased to: _____, Size: _____
- (5) Screen: Size 1/4", Length 10'
- (6) Were any formations sealed against pollution?


yes, no.

If YES depth of formation: fill with sand

Why: around well

Drillers Remarks:

CODED

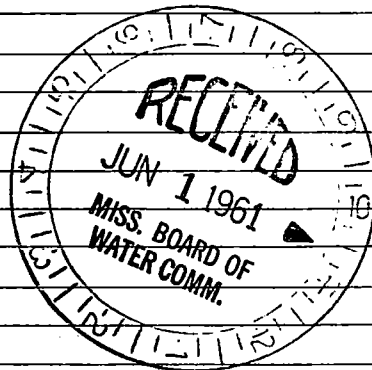

(Use Back Side)

Well No.

Thomas

J.P.

1-1

RT1 Good Observation 179

Red Camp + camp
Blue Camp
Black

2 North Black

X Home was

0
48
42
50

140

Sixth

121

30

10

111

X

Good this life
Camp well