

HAR.

K-

WATER WELL DRILLERS LOG

CODED

11-15-63

Date: 11-15, 1963, Driller: J Reed County Harrison

(Name)

(1) Owner of Land: Elmer Johnson (Name)

RT Box 609 Gulfport Smith Sub Division (Address)

(2) Location: 1/4, 1/4, Sec 34 T2 R12, 5 miles west of Gulfport (distance) (direction) (Nearest Town)

(3) Topography: (Hilly) (Flat) (Level)

(4) Purpose of Well: Home (Domestic irrigation Municipal, Industrial, Other)

Description & Color of Materials Sand, Clay, Red Clay, Shell, etc.	Thick- ness Feet	Depth Feet
Soft mud	20	20
Hard Blue mud	193	213
strata	20	233

CODED

Information upon completion of well:

(1) Diameter 2" x 1 1/4" inches.

(2) Total Depth 233 feet.

(3) Water Level 4 ft feet below top of ground.

(4) Cased to _____, Size _____


(5) Screen: Size 1 1/4" Length 10 ft

(6) Were any formations sealed against pollution? _____ yes, _____ no.

If YES depth of formation _____

Why _____

Drillers Remarks: _____

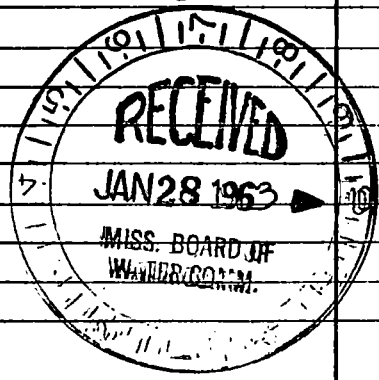

(Use Back Side)

Well No.

