

HAR.

MISSISSIPPI BOARD OF WATER COMMISSIONERS

K 71

B 312809

5-25-66

WATER WELL DRILLERS LOG

Date: 5-25, 1966, Driller C.T. Switzer Well Co. County Harrison

(Name)

(1) Owner of Land: Myrtle Chamblée (Name)

Box 165 Sauer, Miss (Address)

(2) Location: 1/4, 1/4, Sec. 34 T7R12, miles, of (distance) (direction) (Nearest Town)

(3) Topography: X (Hilly) (Flat) (Level)

(4) Purpose of Well: domestic (Domestic Irrigation Municipal, Industrial, Other)

Table with 3 columns: Description & Color of Materials (Sand, Clay, Red Clay, Shell, etc.), Thickness (Feet), and Depth (Feet). Rows contain handwritten entries for various soil layers.

Information upon completion of well:

(1) Diameter 2 inches.

(2) Total Depth 306 feet.

(3) Water Level 35' feet below top of ground.

(4) Cased to 306', Size 2"


(5) Screen: Size 8 gass, Length 10'

(6) Were any formations sealed against pollution? X yes, no.

If YES depth of formation

Why Health Dept. permits.

Drillers Remarks:

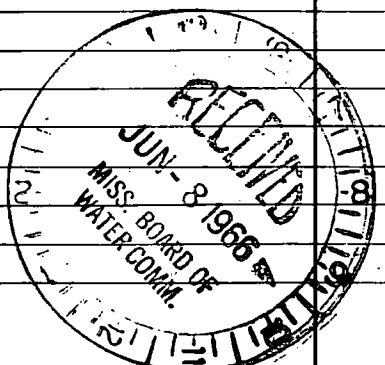

(Use Back Side)

Well No.

