


HAR. MISSISSIPPI BOARD OF WATER COMMISSIONERS
 L 0001
 1-23-64
 WATER WELL DRILLERS LOG

L-15 01795

Date: 1-23-1964, Driller: Layne-Central Co. County Harrison
 (Name)

(1) Owner of Land: City of Gulfport (Name)	Description & Color of Materials Sand, Clay, Red Clay, Shell, etc.	Thick- ness Feet	Depth Feet
Gulfport, Mississippi (Address)	sand	52	0
(2) Location: 1/4, 1/4, Sec. T R, miles of (distance) (direction) (Nearest Town)	clay - sandy stks.	73	125
(3) Topography: (Hilly) (Flat) (Level)	fine sand stks clay	98	223
(4) Purpose of Well: municipal (Domestic Irrigation Municipal, Industrial, Other)	clay	7	230
Information upon completion of well: (1) Diameter 16" inches. (2) Total Depth 758 feet. (3) Water Level 5' feet below top of ground. (4) Cased to 686', Size 16" (5) Screen: Size 10", Length 63' (6) Were any formations sealed against pollution? X yes, no. If YES depth of formation 686' Why required Drillers Remarks:	fine sandy clay-stks cl.	245	475
	clay sandy stks	53	528
	sand	32	560
	sandy shale	40	600
	pk. sand	47	647
	shale	32	679
	pk. sand	76	755
	shale	26	781

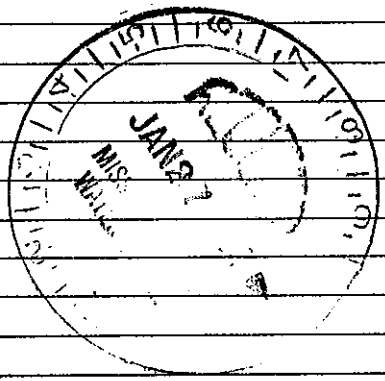

(Use Back Side)

Well No.

Mail this copy to Board of Water Commissioners 429 Miss. St. Jackson, Miss