

HAR

MISSISSIPPI BOARD OF WATER COMMISSIONERS

L0002  
6-17-64  
01 197

WATER WELL DRILLERS LOG

Date: 6-17-1964, Driller: Layne-Central Co. County Harrison

(Name)

(1) Owner of Land: City of Gulfport

(Name)

Gulfport, Mississippi

(Address)

(2) Location: 1/4, 1/4, Sec. T R

S4 T08S R11W

miles of  
(distance) (direction) (Nearest Town)

(3) Topography:

(Hilly) (Flat) (Level)

(4) Purpose of Well: municipal

(Domestic Irrigation  
Municipal, Industrial, Other)

Information upon completion of well:

(1) Diameter 16 inches.

(2) Total Depth 821 feet.

(3) Water Level 3' feet below top of ground.

(4) Cased to 750, Size 16"

(5) Screen: Size 10", Length 60'

(6) Were any formations sealed against pollution?


x yes, no.

If YES depth of formation 750'

Why required

Drillers Remarks:

Description & Color of Materials Sand, Clay, Red Clay, Shell, etc.	Thick- ness Feet	Depth Feet
surface sand	3	3
sand, roots & logs	2	5
loose sand	30	35
soft sand, clay-shells	16	51
soft clay	4	55
sand, shells-clay balls	23	78
clay	31	109
clay-soft stks.	141	250
fine sand	15	265
clay	7	272
fine sand	23	295
clay-sandy stks	65	360
clay	76	436
fine sand-stks clay	29	465
clay, sandy stks	137	602
fine sand - clay	88	690
hard sandy clay	44	734
sand	11	745
sandy clay	7	752
sand	65	817
hard shale	7	824

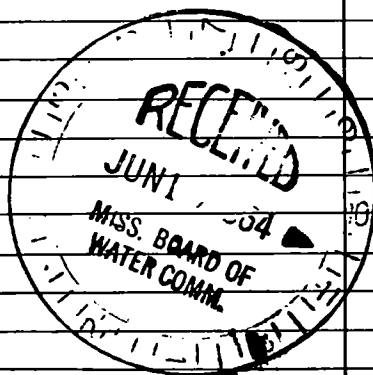

(Use Back Side)

Well No.

