

L22

3-30-62

WATER WELL DRILLERS LOG

CODED
L-514

Date: Mar. 30, 1962, Driller: M&S Drilling Co. County Harrison
(Name)

(1) Owner of Land: Naif Rushing
(Name)
Three Rivers Rd. Gulfport, Miss.
(Address)

(2) Location: SE 1/4, SW 1/4, Sec. 10 T5R11W
5 miles North of Gulfport
(distance) (direction) (Nearest Town)

(3) Topography: Flat
(Hilly) (Flat) (Level)

(4) Purpose of Well: Domestic
(Domestic Irrigation
Municipal, Industrial, Other)

Description & Color of Materials Sand, Clay, Red Clay, Shell, etc.	Thick- ness Feet	Depth Feet
Clay	5	5
White Clay	6	11
White Sand	15	26
Mixed Clay	9	35
Blue Clay	45	80
White Sand (Coarse)	22	102
Blue Clay	1	103
Grey Sand	10	113
Blue Clay	39	152
Sand	5	157
Blue Clay	38	195
Sand	4	199
Blue Clay	37	236
Sand	4	240
Blue Clay	23	263
Sand	5	268
Blue Clay	32	300
Sand	4	304
Blue Clay	16	320
Sand	7	327
Blue Clay	67	394
Grey Sand	16	410
Blue Clay	410	-

Information upon completion of well:

(1) Diameter 2" inches.

(2) Total Depth 409 feet.

(3) Water Level 7 feet below top of ground.

(4) Cased to 379, Size 2"


(5) Screen: Size 2" slot, Length 10 FT.

(6) Were any formations sealed against pollution?
_____ yes, _____ no.

If YES depth of formation _____

Why _____

Drillers Remarks: _____

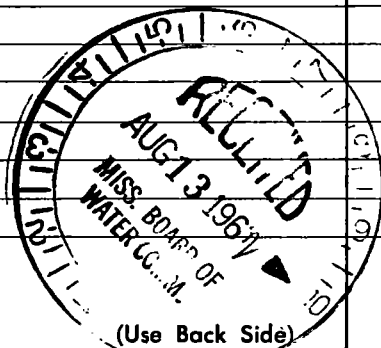

Well No. _____

Handwritten text at the top of the page, possibly a header or title, written in a cursive script.

Vertical handwritten text on the left side of the page, possibly a list or a column of data.

Large block of handwritten text in the center-left area, appearing to be a detailed list or account.

Handwritten text in the upper right quadrant, including the words "Total" and "Total".

Handwritten text in the lower right quadrant, including the words "Total" and "Total".