

HAR.

L 32
1-27-64

WATER WELL DRILLERS LOG

Date: 1-27, 1964, Driller: C. T. SWITZER WELL CO. County: Harrison

(Name)

(1) Owner of Land: Becker Bros Milk Co.
(Name)
3 Rivers Rd, N. Hulfport
(Address)

(2) Location: 1/4, 1/4, Sec. T R
S2 T7S R11W
miles of (distance) (direction) (Nearest Town)

(3) Topography: (Hilly) (Flat) (Level)

(4) Purpose of Well: Commercial
(Domestic Irrigation
Municipal, Industrial, Other)

Description & Color of Materials Sand, Clay, Red Clay, Shell, etc.	Thick- ness Feet	Depth Feet
<u>Sandy clay</u>	<u>00</u>	<u>13</u>
<u>Clay</u>	<u>13</u>	<u>64</u>
<u>Sand w/ clay shls</u>	<u>64</u>	<u>84</u>
<u>Sand</u>	<u>84</u>	<u>111</u>
<u>Clay</u>	<u>111</u>	<u>145</u>
<u>Sand, fine</u>	<u>145</u>	<u>168</u>
<u>Sand</u>	<u>168</u>	<u>169</u>
<u>Clay</u>	<u>169</u>	<u>205</u>
<u>Sand</u>	<u>205</u>	<u>214</u>
<u>Clay</u>	<u>214</u>	<u>242</u>
<u>Sand</u>	<u>242</u>	<u>246</u>
<u>fine sand w/ shls</u>	<u>246</u>	<u>266</u>
<u>Sand & clay</u>	<u>266</u>	<u>286</u>
<u>clay</u>	<u>286</u>	<u>319</u>
<u>sand, fine</u>	<u>319</u>	<u>343</u>
<u>clay</u>	<u>343</u>	<u>349</u>
<u>clay & fullers earth</u>	<u>349</u>	<u>369</u>
<u>fullers earth</u>	<u>369</u>	<u>389</u>
<u>soft mud & fine sand</u>	<u>389</u>	<u>430</u>
<u>clay</u>	<u>430</u>	<u>450</u>
<u>shale</u>	<u>450</u>	<u>490</u>
<u>sand</u>	<u>490</u>	<u>535</u>


Information upon completion of well:

- (1) Diameter 6 1/2 inches.
- (2) Total Depth 535' feet.
- (3) Water Level 10' feet below top of ground.
- (4) Cased to 535', Size 6 1/2"
- (5) Screen: Size 2", Length 40'
- (6) Were any formations sealed against pollution?
yes, no.

If YES depth of formation

Why Health Dept. requirements

Drillers Remarks:

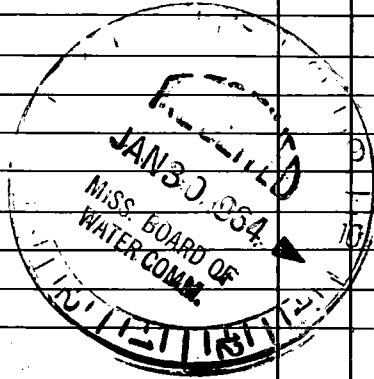

Well No.

(Use Back Side)

1853

1st of the month

of the year

1853

1853