

MISSISSIPPI BOARD OF WATER COMMISSIONERS

HAR.

L 33

7-29-60

WATER WELL DRILLERS LICENSE

CODED

- 300

Date: July 24, 1960, Driller: C. J. Switzer Well Co. County Harrison
(Name)

(1) Owner of Land: Lake View Golf Club
on Bayou View Road - North of
Gulfport Field Lake.
(Address)

(2) Location: $\frac{1}{4}$, $\frac{1}{4}$, Sec. 2 T. R.
5 miles NE, of Gulfport
(distance) (direction) (Nearest Town)

(3) Topography: (Hilly) (Flat) (Level)

(4) Purpose of Well: Domestic
(Domestic Irrigation, Municipal, Industrial, Other)

Information upon completion of well:

(1) Diameter 4 inches.

(2) Total Depth 571 feet.

(3) Water Level 6' feet below top of ground.

(4) Cased to 571', Size 4"

(5) Screen: Size 4" 10g 35, Length 30'

(6) Were any formations sealed against pollution?
 yes, no.


If YES depth of formation 10 feet

Why Health Dept. Requirements

Drillers Remarks:

| Description & Color of Materials Sand, Clay, Red Clay, Shell, etc. | Thick- ness Feet | Depth Feet |
|---|------------------------|---------------|
| Clay | 0 | 12 |
| sand | 12 | 17 |
| Clay | 17 | 63 |
| sand (fine with clay str) | 63 | 85 |
| Clay | 85 | 103 |
| sand | 103 | 148 |
| Clay | 148 | 191 |
| sand - fair | 191 | 233 |
| Clay | 233 | 387 |
| sand | 387 | 395 |
| Clay | 395 | 436 |
| sand | 436 | 460 |
| Clay | 460 | 509 |
| stratified | 509 | 514 |
| good sand | 514 | 529 |
| stratified | 529 | 533 |
| light good sand | 533 | 571 |

CODED

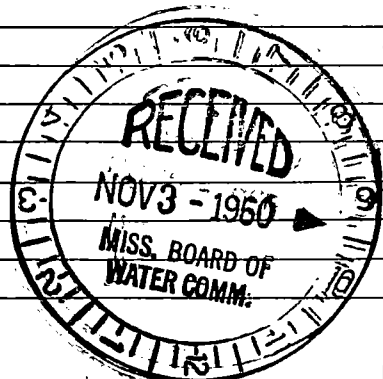

Well No.

