

HAR.

L 36
8-13-60

WATER WELL DRILLERS LOG

CODED

Date Aug 13, 1960, Driller: Joseph A. Melk County Harrison
(Name)

(1) Owner of Land: V.O. Fisher
(Name)
Old Hwy. 49 - Orange Grove
(Address)

(2) Location: 1/4, 1/4, Sec. 5 T. R.
5 miles N of Shelby
(distance) (direction) (Nearest Town)

(3) Topography: Hilly
(Hilly) (Flat) (Level)

(4) Purpose of Well: Domestic
(Domestic Irrigation
Municipal, Industrial, Other)

Description & Color of Materials Sand, Clay, Red Clay, Shell, etc.	Thick- ness Feet	Depth Feet
<u>Surf sand & sand</u>		<u>8</u>
<u>wh. Bl. Clay.</u>	<u>12</u>	<u>20</u>
	<u>65</u>	<u>85</u>
<u>Red sand</u>	<u>25</u>	<u>80</u>
<u>Wh. Clay Sp. Red</u>	<u>15</u>	<u>95</u>
<u>Blue Cl. small</u>	<u>295</u>	<u>390</u>
<u>small sand streaks</u>	<u>25</u>	<u>415</u>
<u>gray sand sand</u>	<u>4</u>	<u>419</u>
<u>(fine)</u>	<u>9</u>	<u>428</u>
<u>hard blue clay</u>	<u>23</u>	<u>451</u>
<u>break.</u>	<u>11</u>	<u>462</u>
<u>Fine Gray Sand</u>	<u>10</u>	<u>472</u>
<u>Gray Sand " Fine</u>	<u>10</u>	<u>482</u>
<u>Gray Sand " Sand</u>	<u>11</u>	<u>493</u>
<u>" " Red Sand</u>	<u>9</u>	<u>502</u>

Information upon completion of well:

(1) Diameter 2 inches.

(2) Total Depth 503 feet. 14' Head.
2000 G.P.H.


(3) Water Level Flowing feet below top of ground.

(4) Cased to 492', Size 2"

(5) Screen: Size 2", Length 10'

(6) Were any formations sealed against pollution?
_____ yes, _____ no.

CODED

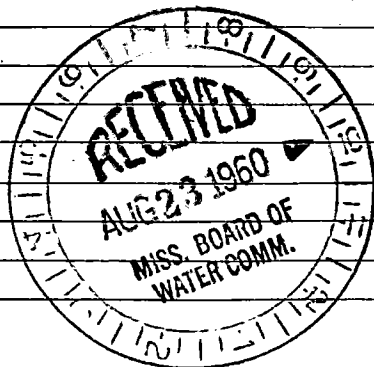

(Use Back Side)

Well No.

over

Handwritten text: H K H

Handwritten text: Handlow

Handwritten text: Old H K H



Handwritten text: Stake

Handwritten text: Orange Grove School