

HAR.

MISSISSIPPI BOARD OF WATER COMMISSIONERS

L 38

4-12-61

WATER WELL DRILLERS CODED

Date: 4-12, 1961, Driller: JRB County Harrison

(Name)

(1) Owner of Land: J. L. Lizana
 (Name)
 London Rt 1 Sulphur
 (Address)

(2) Location: 1/4, 1/4, Sec. 18 T. R.
 2 miles west of London
 (distance) (direction) (Nearest Town)

(3) Topography: (Hilly) (Flat) (Level)

(4) Purpose of Well: Home
 (Domestic Irrigation
 Municipal, Industrial, Other)

Description & Color of Materials Sand, Clay, Red Clay, Shell, etc.	Thick- ness Feet	Depth Feet
	0	
Soft mud & sand	63	
white sand	20	
Hard Blue mud	87	
shells	30	
	200	

Information upon completion of well:

(1) Diameter 2" x 1/4" inches.

(2) Total Depth 200 feet.

(3) Water Level 74 feet below top of ground.

(4) Cased to _____, Size _____

(5) Screen: Size 1/4", Length 10


(6) Were any formations sealed against pollution?
 _____ yes, _____ no.

If YES depth of formation _____

Why _____

Drillers Remarks: _____

CODED

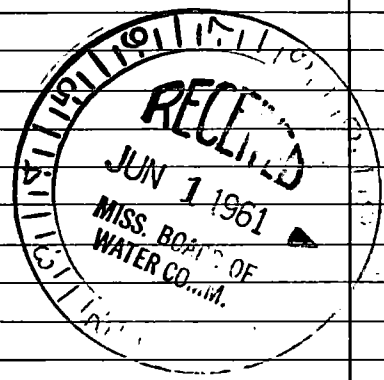

(Use Back Side)

Well No.

0100

88
71