

HAR.

MISSISSIPPI BOARD OF WATER COMMISSIONERS

L41

CODED

314

5-61

WATER WELL DRILLERS LOG

Date: May, 1961, Driller: Joe Miller County Harrison
(Name)

(1) Owner of Land: Leons Club,
(Name)
RCH Gullport,
(Address)

(2) Location: 1/4, 1/4, Sec. 19 T 7 R 11,
1/4 miles North of Gullport,
(distance) (direction) (Nearest town)

(3) Topography: Hilly
(Hilly) (Flat) (Level)

(4) Purpose of Well: Club,
(Domestic Irrigation
Municipal, Industrial, Other)

Description & Color of Materials Sand, Clay, Red Clay, Shell, etc.	Thick- ness Feet	Depth Feet
Surface		5
W/tp Sand	11	16
W/tp Cl, Red Cl.	19	35
W/tp Cl.	25	60
Red Sand + Cl Mud	38	98
W/tp W/tp + Blu Cl.	24	122
Blu Sand, N.G.	6	128
Blu Cl, Brn Br.	428	556
W/tp Blu Cl.	74	630
Fine Yea Sand	52	682
Fine " "	21	703
Sand, Good	12	715
Cl. Strata	3	718
Sand, Fine	6	724
Sand - Good	32	756

Information upon completion of well:

(1) Diameter 2 inches.

(2) Total Depth 756' feet

(3) Water Level 22" inch feet below top of ground.

(4) Cased to 736, Size 2"


(5) Screen: Size 2", Length 70'

(6) Were any formations sealed against pollution?
_____ yes, _____ no.

756 - 758
Oly.

If YES depth of formation _____
Why _____

Drillers Remarks: Rumpkin 2000 G PIT.
By this

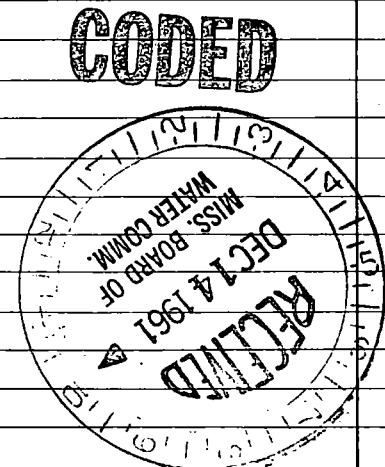

(Use Back Side)

Well No.



49

Ku

London Rd

Boys
Bernard

well

N