

HAR.

L42

WATER WELL DRILLERS LOG

CODED

Date: July 3, 1961, Driller: C. T. SWITZER WELL CO. County: Harrison

(Name)

(1) Owner of Land: E. J. Benton
(Name)
West 28th St
(Address)

(2) Location: 1/4, 1/4, Sec. 32 T. R.
_____ miles _____ of _____
(distance) (direction) (Nearest Town)

(3) Topography: X
(Hilly) (Flat) (Level)

(4) Purpose of Well: Domestic
(Domestic Irrigation
Municipal, Industrial, Other)

Description & Color of Materials Sand, Clay, Red Clay, Shell, etc.	Thick- ness Feet	Depth Feet
clay	0	10
sand	10	20
clay	20	62
sand	62	72
clay	72	146
sand	146	154
clay	154	198
sand	198	241

Information upon completion of well:

(1) Diameter 2 inches.

(2) Total Depth 241 feet.

(3) Water Level 6 feet below top of ground.

(4) Cased to 241, Size 2 inches.

(5) Screen: Size 2 inches, Length 10 feet.


(6) Were any formations sealed against pollution?
X yes, _____ no.

If YES depth of formation _____

Why Health Dept Requirement

Drillers Remarks: _____

CODED

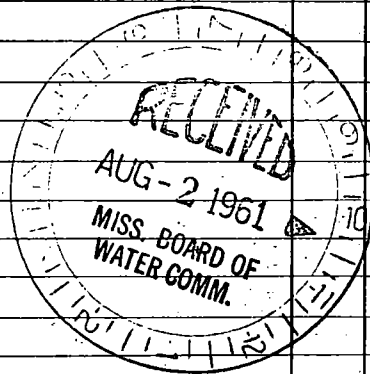

(Use Back Side)

Well No.

Handwritten text at the top of the page, possibly a header or title, including the number "100" on the left and "100" on the right.

1	2	3	4	5	6	7	8	9	10
11	12	13	14	15	16	17	18	19	20
21	22	23	24	25	26	27	28	29	30
31	32	33	34	35	36	37	38	39	40
41	42	43	44	45	46	47	48	49	50
51	52	53	54	55	56	57	58	59	60
61	62	63	64	65	66	67	68	69	70
71	72	73	74	75	76	77	78	79	80
81	82	83	84	85	86	87	88	89	90
91	92	93	94	95	96	97	98	99	100

Handwritten notes or calculations in the middle-left section of the page.

Handwritten notes or calculations in the middle-right section of the page.

Handwritten text or a signature in the lower-middle section of the page.

Handwritten text at the bottom of the page, possibly a signature or date.