

HAR.  
L 46  
2-19-62

WATER WELL DRILLERS LOG

COMMISSIONERS  
**CODED**

L-309

Date: 2/19, 1962, Driller: H. A. Ladner County Harrison  
(Name)

(1) Owner of Land:	Description & Color of Materials Sand, Clay, Red Clay, Shell, etc.	Thick- ness Feet	Depth Feet
<u>Leslie M. Hammers</u> (Name)	<u>yellow clay</u>	<u>18</u>	
<u>North of Guffport</u> (Address)	<u>sand</u>	<u>5</u>	
(2) Location: <u>1/4</u> , <u>1/4</u> , Sec. <u>2</u> T <u>7</u> S R <u>11</u> W	<u>clay</u>	<u>2</u>	
<u>6</u> miles <u>north</u> , of <u>Guffport</u> (distance) (direction) (Nearest Town)	<u>sand</u>	<u>5</u>	
(3) Topography: <u>Hilly</u> (Hilly) (Flat) (Level)	<u>clay</u>	<u>3</u>	
(4) Purpose of Well: <u>Domestic</u> (Domestic Irrigation Municipal, Industrial, Other)	<u>sand</u>	<u>20</u>	

Information upon completion of well:


- (1) Diameter 1 1/4 inches.
- (2) Total Depth 138 feet.
- (3) Water Level 4 feet below top of ground.
- (4) Cased to 134, Size 1 1/4
- (5) Screen: Size 80, Length 10
- (6) Were any formations sealed against pollution?  
 yes,  no.

If YES depth of formation all

Why Sandy

Drillers Remarks:

**CODED**

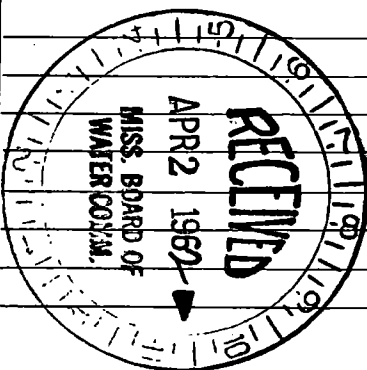

(Use Back Side)

Well No.

Retain this copy for your office files.

1933

1933  
