

HAR.

MISSISSIPPI BOARD OF WATER COMMISSIONERS

L 50

3-28-62

WATER WELL DRILLERS LOG

L-313

CODED

Date: Mar 28, 1962, Driller: MWB Drilling Co. County: Lewis
(Name)

(1) Owner of Land: Bowen Davis
(Name)
Gulfport Miss.
(Address)

(2) Location: SE 1/4, SE 1/4, Sec. 5 P5W14E
7 miles North of Gulfport
(distance) (direction) (Nearest Town)

(3) Topography: Flat
(Hilly) (Flat) (Level)


(4) Purpose of Well: Domestic
(Domestic Irrigation
Municipal, Industrial, Other)

Description & Color of Materials Sand, Clay, Red Clay, Shell, etc.	Thick- ness Feet	Depth Feet
Clay	10	10
White Sand	20	30
Silt & Sand	30	60
White Clay	10	70
Clay Silt & Sand	40	110
Blue Clay	92	202
Sand + Clay Breaks	6	208
Blue Clay	82	290
Grey Sand	6	296
Blue Clay	107	403
Sand	4	407
Blue Clay	3	410
Grey Sand	36	446
Blue Clay	446	-

Information upon completion of well:
105 FT, 3", Balance 2"
 (1) Diameter _____ inches.
 (2) Total Depth 446 feet.
 (3) Water Level 17 feet below top of ground.
 (4) Cased to 426, Size 3" & 2"
 (5) Screen: Size 2" 8 slot, Length 10 FT.
 (6) Were any formations sealed against pollution?
 _____ yes, _____ no.

If YES depth of formation _____
 Why _____
 Drillers Remarks: _____

CODED

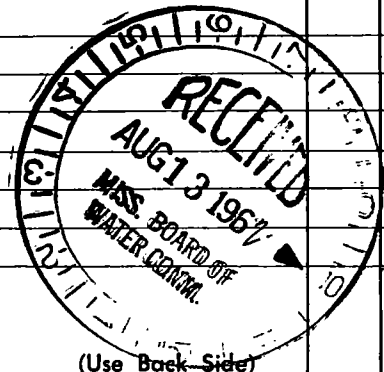

(Use Back Side)

Well No.

Handwritten notes on the left margin, including numbers and dates.

Main body of handwritten notes, possibly a list or series of entries.

Handwritten notes on the right side of the page, including some larger, bolded text.