

HAR.
L 51

MISSISSIPPI BOARD OF WATER COMMISSIONERS

4-20-62

WATER WELL DRILLERS LOG

(9) **L**
CODED

Date: Apr 20, 1962, Driller: Joe Miller County: Harrison
(Name)

(1) Owner of Land:	Description & Color of Materials Sand, Clay, Red Clay, Shell, etc.	Thick- ness Feet	Depth Feet
<u>L. A. Payne</u> (Name) <u>RM # 2 Box 194 Sulfur Miss</u> (Address)	<u>Surface</u>		<u>8</u>
(2) Location: <u>1/4</u> , <u>1/4</u> , Sec. <u>8 T8R11W</u>	<u>Sand Red</u>	<u>44</u>	<u>52</u>
<u>5</u> miles <u>North</u> of <u>Sulfur</u> (distance) (direction) (Nearest Town)	<u>White Clay (sand st.)</u>	<u>66</u>	<u>118</u>
(3) Topography: <u>Hilly</u> (Hilly) (Flat) (Level)	<u>Blue Clay</u>	<u>242</u>	<u>360</u>
(4) Purpose of Well: <u>Domestic</u> (Domestic Irrigation Municipal, Industrial, Other)	<u>Fin sand Fine</u>	<u>17</u>	<u>377</u>
	<u>Fin sand Fine</u>	<u>11</u>	<u>388</u>
	<u>" " Sulf. Ball</u>	<u>12</u>	<u>400</u>
	<u>" " " " "</u>	<u>10</u>	<u>410</u>
	<u>" " " " "</u>		<u>420</u>


Information upon completion of well:

- (1) Diameter 2 inches.
- (2) Total Depth 412 feet.
- (3) Water Level 15' feet below top of ground.
- (4) Cased to 460, Size 2"
- (5) Screen: Size 2", Length 10'
- (6) Were any formations sealed against pollution?
_____ yes, _____ no.

If YES depth of formation _____
Why _____

Drillers Remarks: Driller to 525
sand isn't too good
at 410. No sand out
this depth as there is in other areas around
(Use Back Side) here

CODED

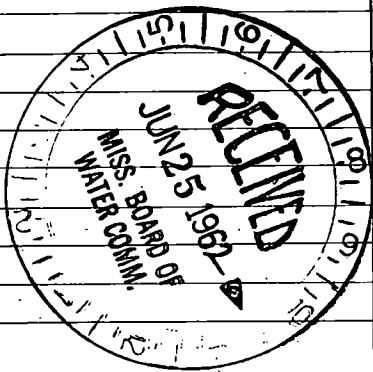

Well No. _____

1009

[Faint handwritten notes]

