

L53
6-23-62

WATER WELL DRILLERS LOG

L
CODED

Date: 6-23, 1962, Driller: M+B Drilling Co. County Harrison
(Name)

(1) Owner of Land: Luther Arrean
(Name)
Herring Pl., Gulfport Miss
(Address)

(2) Location: SW 1/4, NE 1/4, Sec. 5 T25R11W
1/2 miles W of Nugent
(distance) (direction) (Nearest Town)

(3) Topography: Flat
(Hilly) (Flat) (Level)

(4) Purpose of Well: Domestic
(Domestic Irrigation
Municipal, Industrial, Other)

Description & Color of Materials Sand, Clay, Red Clay, Shell, etc.	Thick- ness Feet	Depth Feet
<u>Clay</u>	<u>8</u>	<u>8</u>
<u>White Sand</u>	<u>15</u>	<u>23</u>
<u>White Clay</u>	<u>105</u>	<u>28</u>
<u>Blue Clay</u>	<u>272</u>	<u>508</u>
<u>Fine Gray Sand</u>	<u>15</u>	<u>415</u>
<u>Blue Clay</u>	<u>73</u>	<u>458</u>
<u>Grey Sand</u>	<u>25</u>	<u>493</u>
<u>Still cutting sand at 493</u>		

Information upon completion of well:

(1) Diameter 2 inches.

(2) Total Depth 493 feet.

(3) Water Level 23 feet below top of ground.

(4) Cased to 483, Size 2"

(5) Screen: Size 2" X 2 1/4" Length 10 FT


(6) Were any formations sealed against pollution?
_____ yes, _____ no.

If YES depth of formation _____

Why _____

Drillers Remarks: _____

CODED

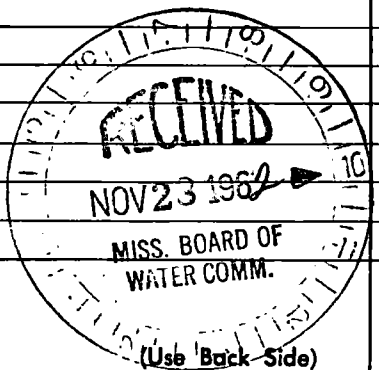

Well No.

COPIED