

HAR.
L 54
7-3-62

WATER WELL DRILLERS LOG

CODED

Date: July 3, 1962, Driller: Joe Miller County Harrison
(Name)

(1) Owner of Land: Louis H. Pitts
(Name)
R.R. # 2, Sulfport Miss
(Address)

(2) Location: $\frac{1}{4}$, 04 $\frac{1}{4}$, Sec. 10 T 75 R 11 W
5 miles North East of Sulfport
(distance) (direction) (Nearest Town)

(3) Topography: Hilly
(Hilly) (Flat) (Level)

(4) Purpose of Well: Domestic
(Domestic Irrigation
Municipal, Industrial, Other)

Description & Color of Materials Sand, Clay, Red Clay, Shell, etc.	Thick- ness Feet	Depth Feet
Surface	8	8
White sand gravel (P)	18	26
Brown Clay	9	35
Blue Clay	40	75
Gray sand	25	100
Brown sand	4	104
Blue Clay	146	250
Gray sand (fine)	11	261
Blue Clay	19	280
Gray sand (fine)	12	292
Gray sand (fine)	6	298
Blue Clay (sand)	18	416
Gray sand (fine)	12	428
Gray sand (fine)	42	536
Gray sand (fine)	32	568
Clay + 2 sand mud	11	579
NG		

Information upon completion of well:

(1) Diameter 2" inches.

(2) Total Depth 579' feet.

(3) Water Level 18' feet below top of ground.

(4) Cased to 558', Size 2"

(5) Screen: Size 2", Length 10'


(6) Were any formations sealed against pollution?
_____ yes, _____ no.

If YES depth of formation _____

Why _____

Drillers Remarks: _____


CODED

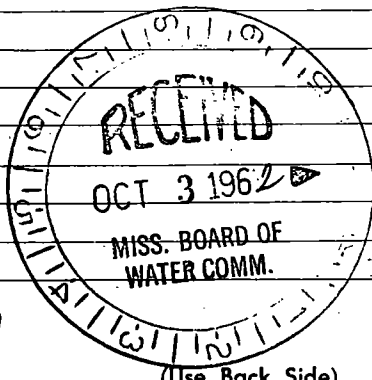

Well No.

1950

Yuffert

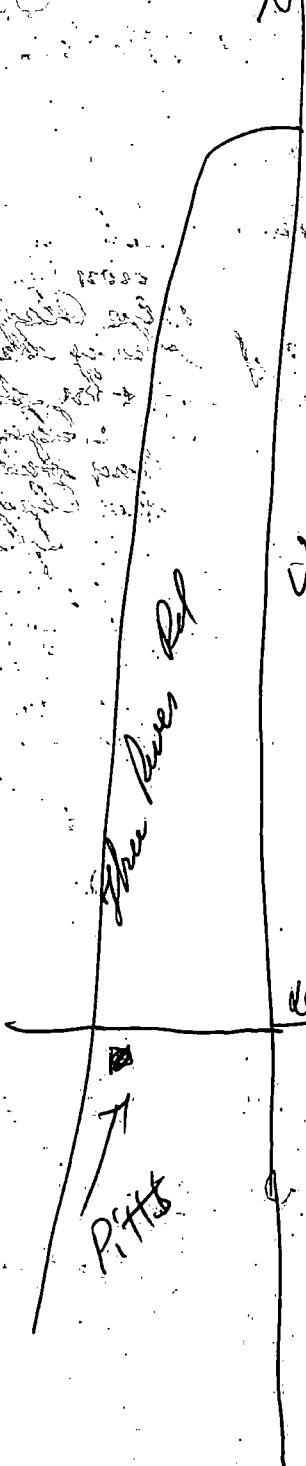

Shaw River Rd

OS HKy 49

Beaudoux Rd

Pitts

M