

HAR.
L 55
7-14-62

WATER WELL DRILLERS LOG

CODED

L-310

Date: July 14, 1962, Driller: M & B Drilling Co. County Harrison

(Name)

(1) Owner of Land: Vardaman Spears, Jr.
(Name)
Taylor Blvd off Creosote Rd.
N. Gulfport (Address) Miss

(2) Location: ONE 1/4, NW 1/4, Sec. 22 T21R11W
2 miles N, of Gulfport
(distance) (direction) (Nearest Town)

(3) Topography: Flat
(Hilly) (Flat) (Level)

(4) Purpose of Well: Domestic
(Domestic Irrigation
Municipal, Industrial, Other)

Description & Color of Materials Sand, Clay, Red Clay, Shell, etc.	Thick- ness Feet	Depth Feet
Clay	16	16
White Sand	14	30
Blue Clay	75	105
Grey Sand	19	124
Blue Clay	19	143
Fine Grey Sand	55	198
Blue Clay	31	229
Medium Grey Sand	70	299
Blue Clay - 251 -		

Information upon completion of well:

(1) Diameter 2 inches.

(2) Total Depth 250 feet.

(3) Water Level Flowing slightly feet below top of ground.

(4) Cased to 240, Size 2"

(5) Screen: Size 2" slot, Length 10 FT.


(6) Were any formations sealed against pollution?
_____ yes, _____ no.

CODED

If YES depth of formation _____

Why _____

Drillers Remarks: _____

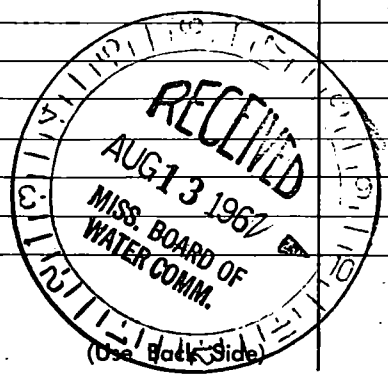

Well No.

