

HAR.

MISSISSIPPI BOARD OF WATER COMMISSIONERS

CODED

L 56

WATER WELL DRILLERS LOG

8-2-62

Date: 8-2, 1962, Driller: Sutter Well Works County Harrison

(Name)

(1) Owner of Land:	Description & Color of Materials Sand, Clay, Red Clay, Shell, etc.	Thick- ness Feet	Depth Feet
<u>Bryan Baker</u> (Name) <u>Rt 2 Gulfport</u> (Address)	<u>Clay</u> <u>sand</u>	<u>80</u>	<u>80</u>
(2) Location: <u>NE 1/4, SE 1/4, Sec. 6 T25R11W</u>	<u>Clay</u> <u>sand</u>	<u>40</u>	<u>120</u>
<u>2</u> miles <u>W</u> , of <u>Orange Grove</u> (distance) (direction) (Nearest town)	<u>Clay</u> <u>sand</u>	<u>33</u>	<u>153</u>
(3) Topography: <u>hilly</u> (Hilly) (Flat) (Level)	<u>Clay</u> <u>sand</u>	<u>22</u>	<u>175</u>
(4) Purpose of Well: <u>domestic</u> (Domestic Irrigation Municipal, Industrial, Other)	CODED		


Information upon completion of well:

- (1) Diameter 2 inches.
- (2) Total Depth 175 feet.
- (3) Water Level 21 feet below top of ground.
- (4) Cased to all, Size 2"
- (5) Screen: Size 2", Length 5'
- (6) Were any formations sealed against pollution?
no

If YES depth of formation _____

Why _____

Drillers Remarks: _____

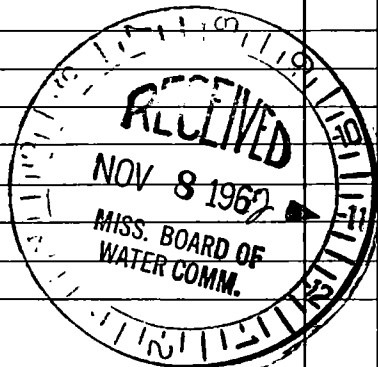

(Use Back Side)

Well No.

100

100

