

HAR.

L 58

9-10-62


WATER WELL DRILLERS

CODED

Date: 9-10, 1962, Driller: Joe Miller County Harrison
 (Name)

	Description & Color of Materials Sand, Clay, Red Clay, Shell, etc.	Thick- ness Feet	Depth Feet
(1) Owner of Land: <u>Mrs. Clara Brown</u> (Name) <u>RR# Sulfport, Miss</u> (Address)	<u>Surface</u>	<u>10'</u>	<u>10'</u>
(2) Location: <u>SE 1/4, NW 1/4, Sec. 28 T23R11W</u>	<u>Red Sand</u>	<u>25</u>	<u>35</u>
<u>5</u> miles <u>North</u> of <u>Sulfport</u> (distance) (direction) (Nearest Town)	<u>Wh Cl Shub Bl Clay</u>	<u>75</u>	<u>110</u>
(3) Topography: <u>Hilly</u> (Hilly) (Flat) (Level)	<u>Blue Clay</u>	<u>235</u>	<u>345</u>
(4) Purpose of Well: <u>Domestic</u> (Domestic Irrigation Municipal, Industrial, Other)	<u>Gray Sand. (Fine)</u>	<u>33</u>	<u>378</u>
Information upon completion of well:	<u>" " " "</u>	<u>22</u>	<u>400</u>
(1) Diameter <u>2"</u> inches.	<u>" " " " (Fair)</u>	<u>7</u>	<u>407</u>
(2) Total Depth <u>552'</u> feet.	<u>Blue Clay</u>	<u>5</u>	<u>412</u>
(3) Water Level <u>16'</u> feet below top of ground.	<u>Sand. Gray (Fine)</u>	<u>38</u>	<u>450</u>
(4) Cased to <u>540'</u> , Size <u>2"</u>	<u>Hard Blue Clay</u>	<u>15</u>	<u>465</u>
(5) Screen: Size <u>2"</u> , Length <u>10'</u> <u>2" Fall Pipe.</u>	<u>Gray Sand. Fine</u>	<u>40</u>	<u>505</u>
(6) Were any formations sealed against pollution? <u>_____</u> yes, <u>_____</u> no.	<u>Gray Sand. Fair</u>	<u>11</u>	<u>516</u>
If YES depth of formation _____	<u>Gray Sand. (Coarse)</u>	<u>34</u>	<u>550</u>
Why _____	<u>Hard Blue Clay</u>	<u>2</u>	<u>552</u>
Drillers Remarks: _____			

CODED

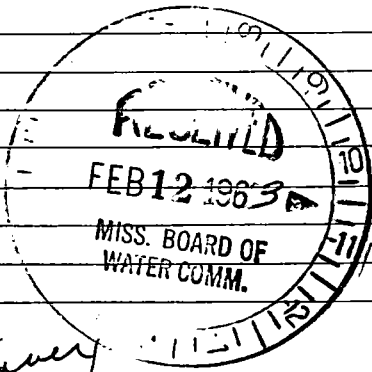

(Use Back Side)

Well No.

Shefford

London

old Hwy 49

Orange Grove School

□ Mrs Brown