

MISSISSIPPI BOARD OF WATER COMMISSIONERS

HAR.
L 59
9-18-62

WATER WELL DRILLERS LOG

CODED

Date Sept. 18, 1962, Driller: M. B. Drilling Co County Harrison
(Name)

(1) Owner of Land: James Walker
(Name)
R. B. Cullport, Miss
(Address)

(2) Location: SE 1/4, NE 1/4, Sec. 11 T. 75 N. R. 11 W.
_____ miles _____ of _____
(distance) (direction) (Nearest Town)

(3) Topography: Flat
(Hilly) (Flat) (Level)

(4) Purpose of Well: Domestic
(Domestic Irrigation
Municipal, Industrial, Other)

Description & Color of Materials Sand, Clay, Red Clay, Shell, etc.	Thick- ness Feet	Depth Feet
<u>Red Clay</u>	<u>14</u>	<u>14</u>
<u>Blue Clay</u>	<u>196</u>	<u>210</u>
<u>Sand Break</u>	<u>6</u>	<u>216</u>
<u>Blue Clay</u>	<u>48</u>	<u>264</u>
<u>Grey Sand</u>	<u>29</u>	<u>293</u>
<u>Blue Clay 293 m</u>		

Information upon completion of well:

(1) Diameter 2 inches.

(2) Total Depth 291 feet.

(3) Water Level 25 feet below top of ground.

(4) Cased to 281, Size 2"


(5) Screen: Size 2" x 8 slot, Length 10 FT.

(6) Were any formations sealed against pollution?
_____ yes, _____ no.

If YES depth of formation _____

Why _____

Drillers Remarks: _____

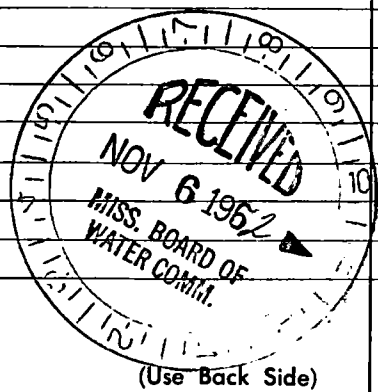

Well No.

0000