

L60
10-11-62

WATER WELL DRILLERS LOG **CODED**

Date: Oct. 11, 1962, Driller: M & B Drilling Co. County Harrison
(Name)

(1) Owner of Land: C. M. Gordon
(Name)
R. R. Cullfort, Miss.
(Address)

(2) Location: SW 1/4, SE 1/4, Sec. 5 T5R11W
6 miles N of Cullfort
(distance) (direction) (Nearest Town)

(3) Topography: Slightly Rolling
(Hilly) (Flat) (Level)

(4) Purpose of Well: Domestic - Several Homes.
(Domestic Irrigation, Municipal, Industrial, Other)

Description & Color of Materials Sand, Clay, Red Clay, Shell, etc.	Thick- ness Feet	Depth Feet
<u>Clay</u>	<u>26</u>	<u>26</u>
<u>Blue Clay</u>	<u>67</u>	<u>90</u>
<u>White Sand</u>	<u>25</u>	<u>115</u>
<u>Blue Clay</u>	<u>292</u>	<u>407</u>
<u>Grey Sand</u>	<u>34</u>	<u>441</u>
<u>Blue Clay</u>	<u>44</u>	<u>500</u>

Information upon completion of well:
84 FT 3" Top - Balanced "

(1) Diameter 3 inches.

(2) Total Depth 437 feet.

(3) Water Level 26 feet below top of ground.

(4) Cased to 427, Size 3" X 2"

(5) Screen: Size 2" X 3/16" Length 10 FT.


(6) Were any formations sealed against pollution?
_____ yes, _____ no.

If YES depth of formation _____

Why _____

Drillers Remarks: _____

CODED

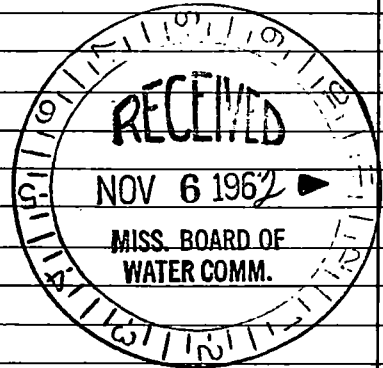

(Use Back Side)

Well No.

