

HAR.
L 68
11-25-63

WATER WELL DRILLERS LOG

CODED

Date: 11-25, 1963, Driller: Sutter Well Wks county Harrison
(Name)

(1) Owner of Land: Claida Ziemke
(Name)
Rt. 2, Box 323-F, Gulfport, Miss
(Address)

(2) Location: SW 1/4, NE 1/4, Sec. 17 T7S R11W
4 miles N of Gulfport
(distance) (direction) (Nearest Town)

(3) Topography: hilly
(Hilly) (Flat) (Level)

(4) Purpose of Well: domestic
(Domestic Irrigation
Municipal, Industrial, Other)

Description & Color of Materials Sand, Clay, Red Clay, Shell, etc.	Thick- ness Feet	Depth Feet
<u>Clay - small str. sand</u>	<u>0</u>	<u>422</u>
<u>Clay</u>	<u>24</u>	<u>446</u>
<u>sand</u>	<u>12</u>	<u>458</u>
<u>Clay</u>	<u>9</u>	<u>467</u>
<u>sand</u>	<u>39</u>	<u>506</u>

CODED

Information upon completion of well:

(1) Diameter 2 inches.

(2) Total Depth 506 feet.

(3) Water Level 35 feet below top of ground.

(4) Cased to all, Size 2"


(5) Screen: Size 2", Length 10'

(6) Were any formations sealed against pollution?
_____ yes, _____ no.

If YES depth of formation _____

Why _____

Drillers Remarks: _____

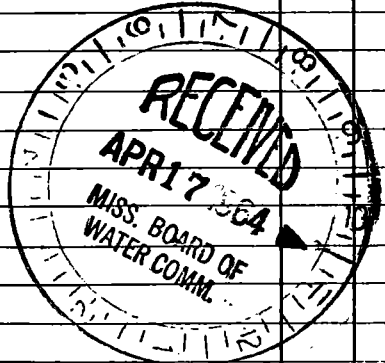

(Use Back Side)

Well No.

4 31